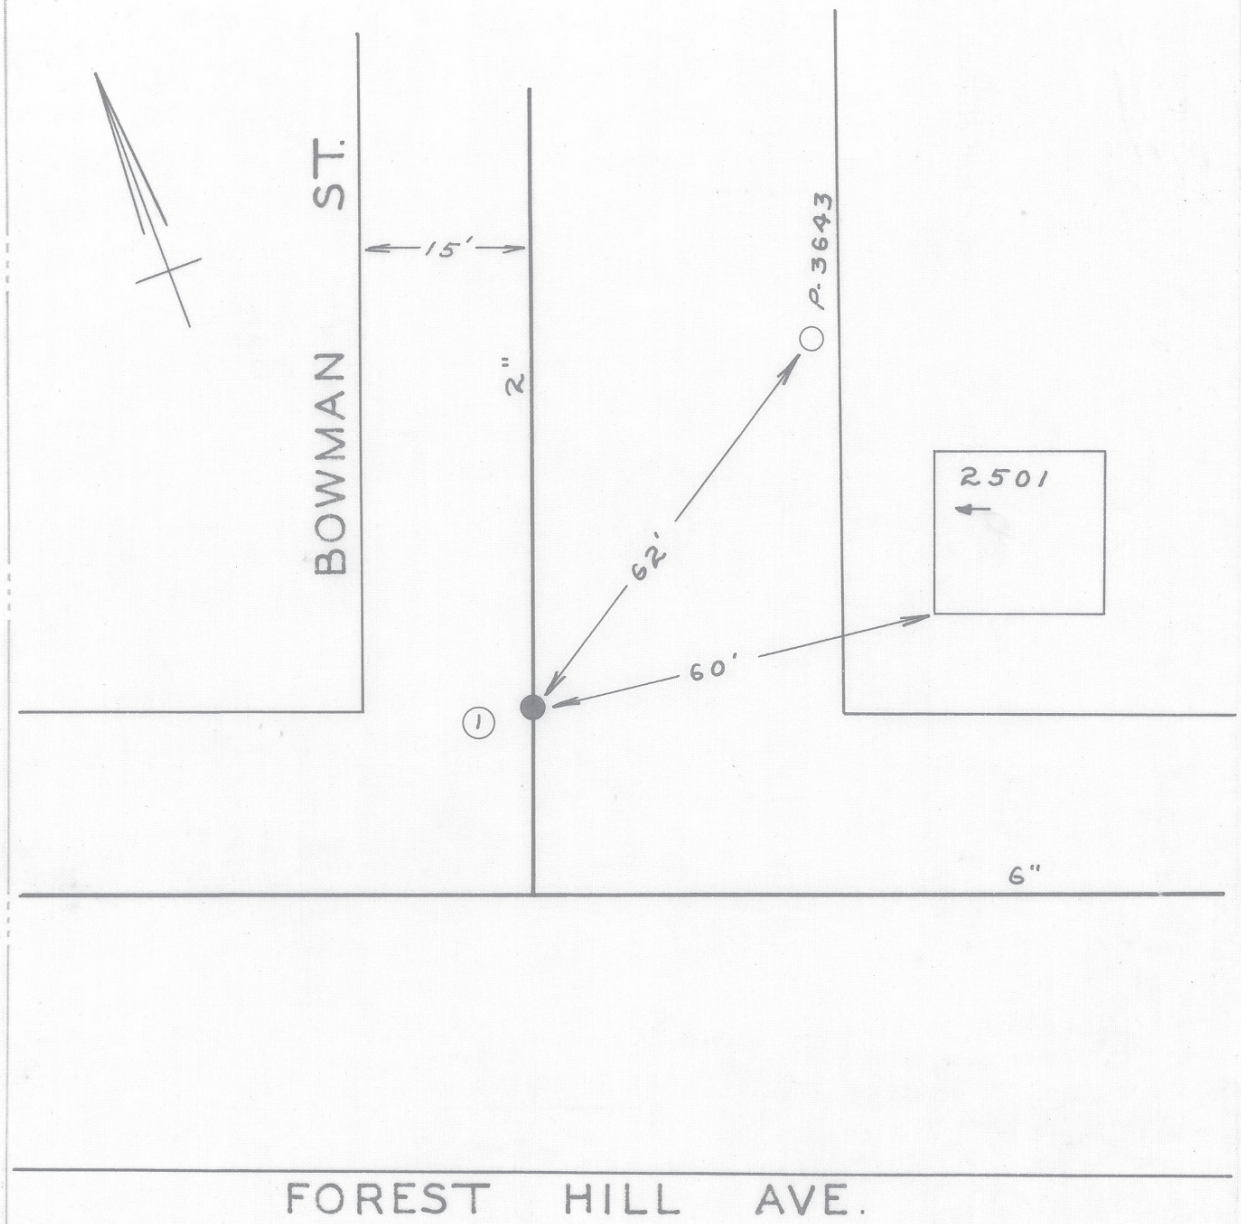

DATE	NO.	SIZE	MAKE	OPEN	TURNS
7-'54	1	2"	DARLING	R	7
	1	0	NPL		

CITY OF ROANOKE—WATER DEPT.

VALVE DIAGRAM

BOWMAN ST. & FOREST HILL AVE. N. W.

SEC. MAP 207

DATE PAGE NO.

2/87 NP

"IMPERIAL" TRACING CLOTH H. & B. CO., N. Y.