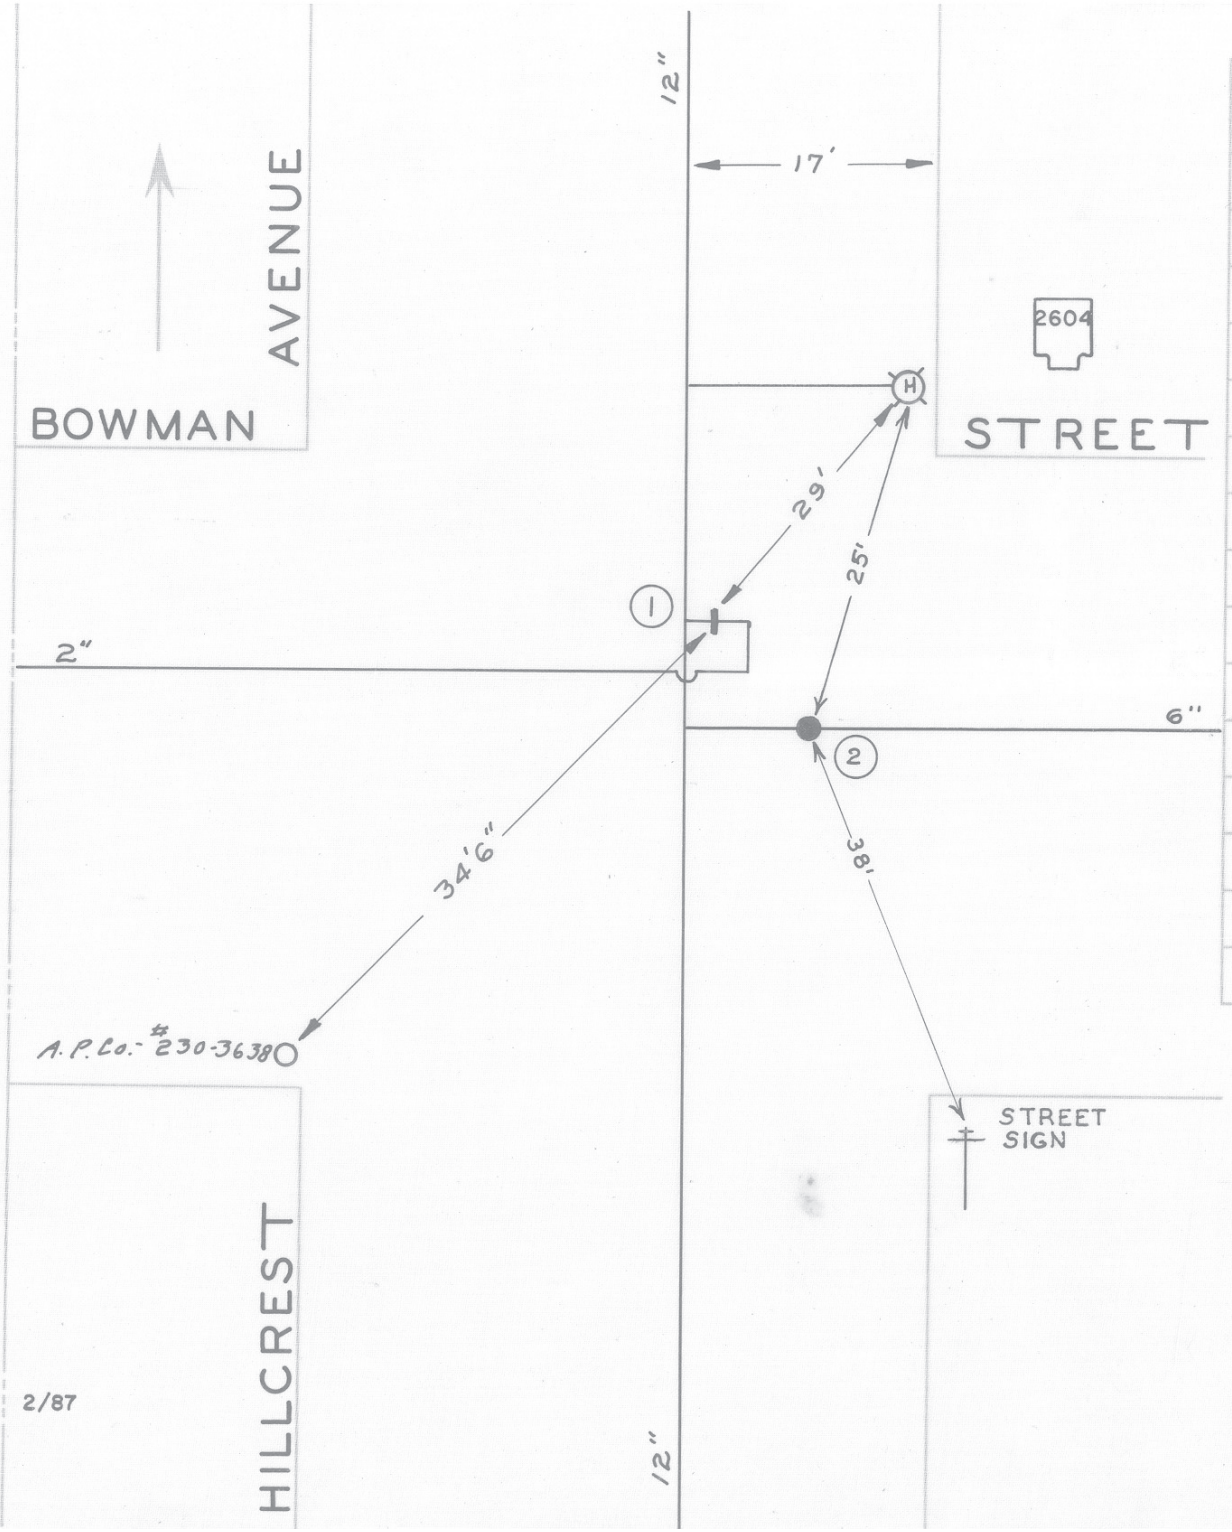

DATE	NO.	SIZE	MAKE	OPEN	TURNS
'58	1	2"	DARLING	R.	
61'	2	6"	DARLING	R	
	1	9'-S	NPL		
	2	15'W	EPL		

CITY OF ROANOKE—WATER DEP'T

VALVE DIAGRAM

BOWMAN ST. &

HILLCREST AVE. N. W.

SEC. MAP 207

DATE PAGE NO.

2/87