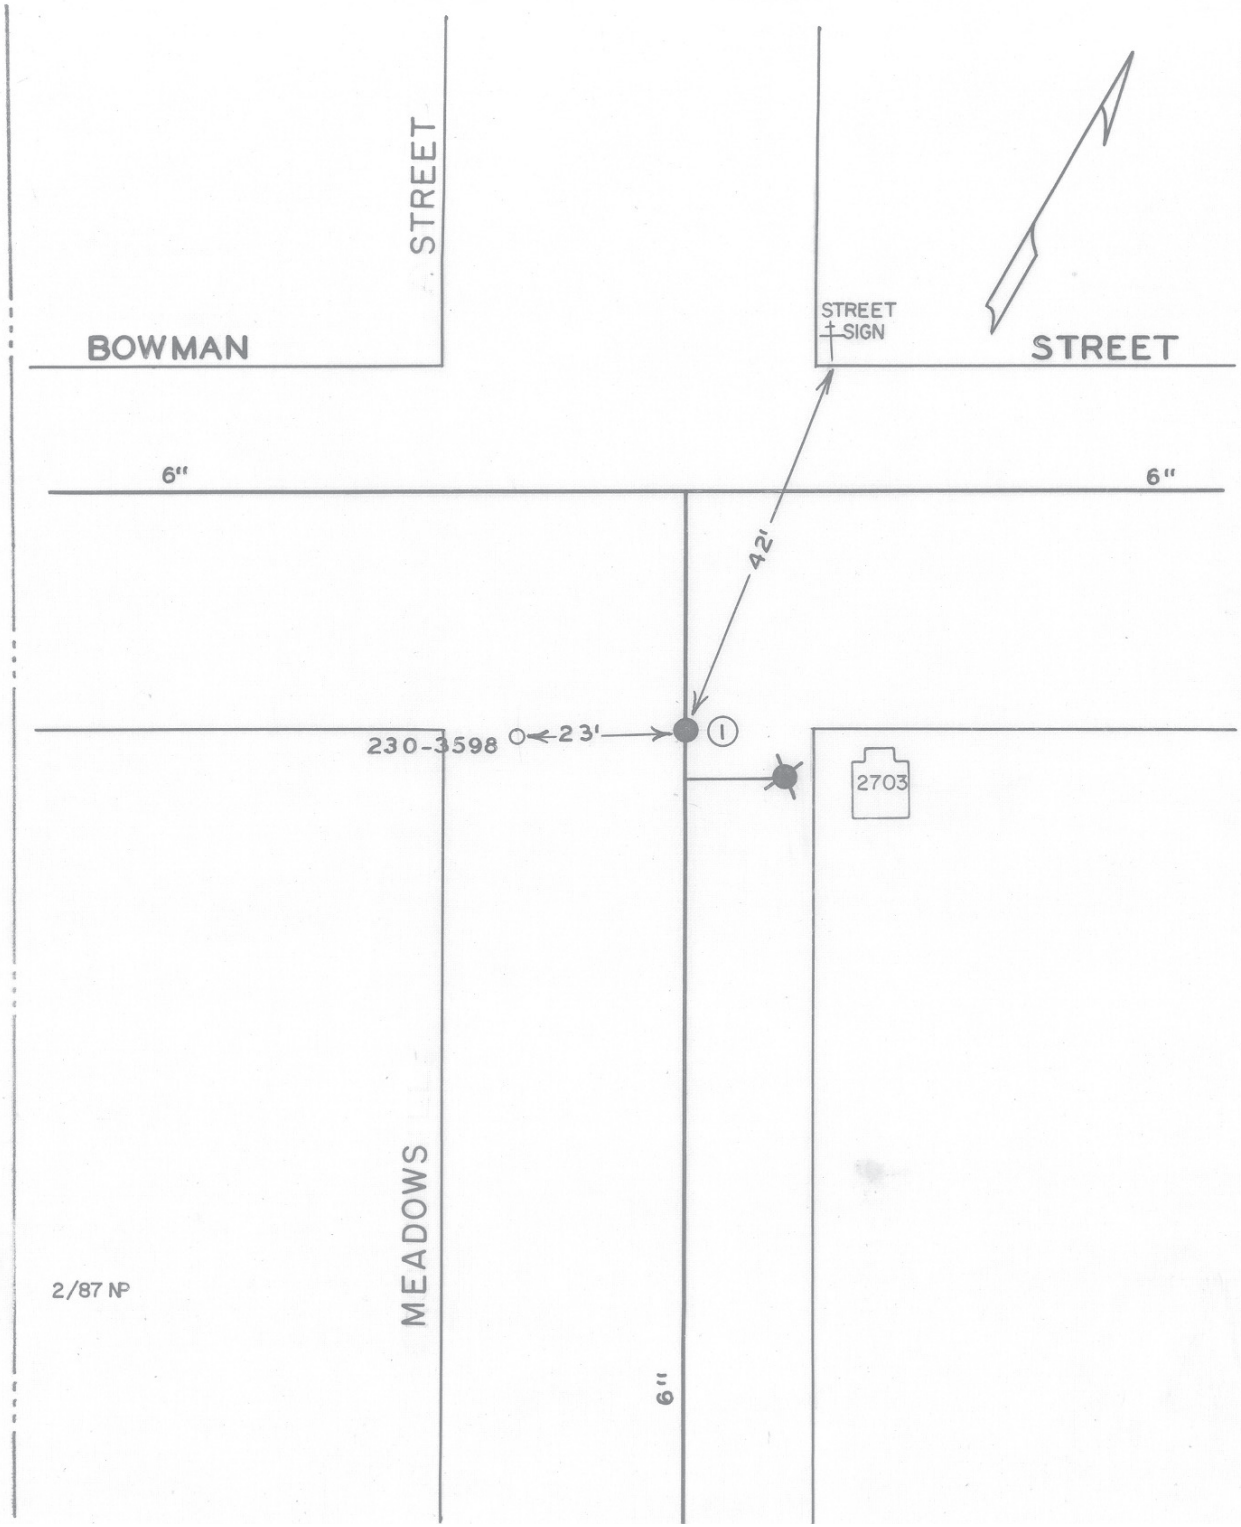

DATE	NO.	SIZE	MAKE	OPEN	TURNS
10-64	1	6"	MUELLER	R	
	1	0	S.P.L.		

CITY OF ROANOKE—WATER DEPT.

VALVE DIAGRAM

BOWMAN STREET &
MEADOWS STREET

SEC. MAP 207 NW

DATE PAGE NO.