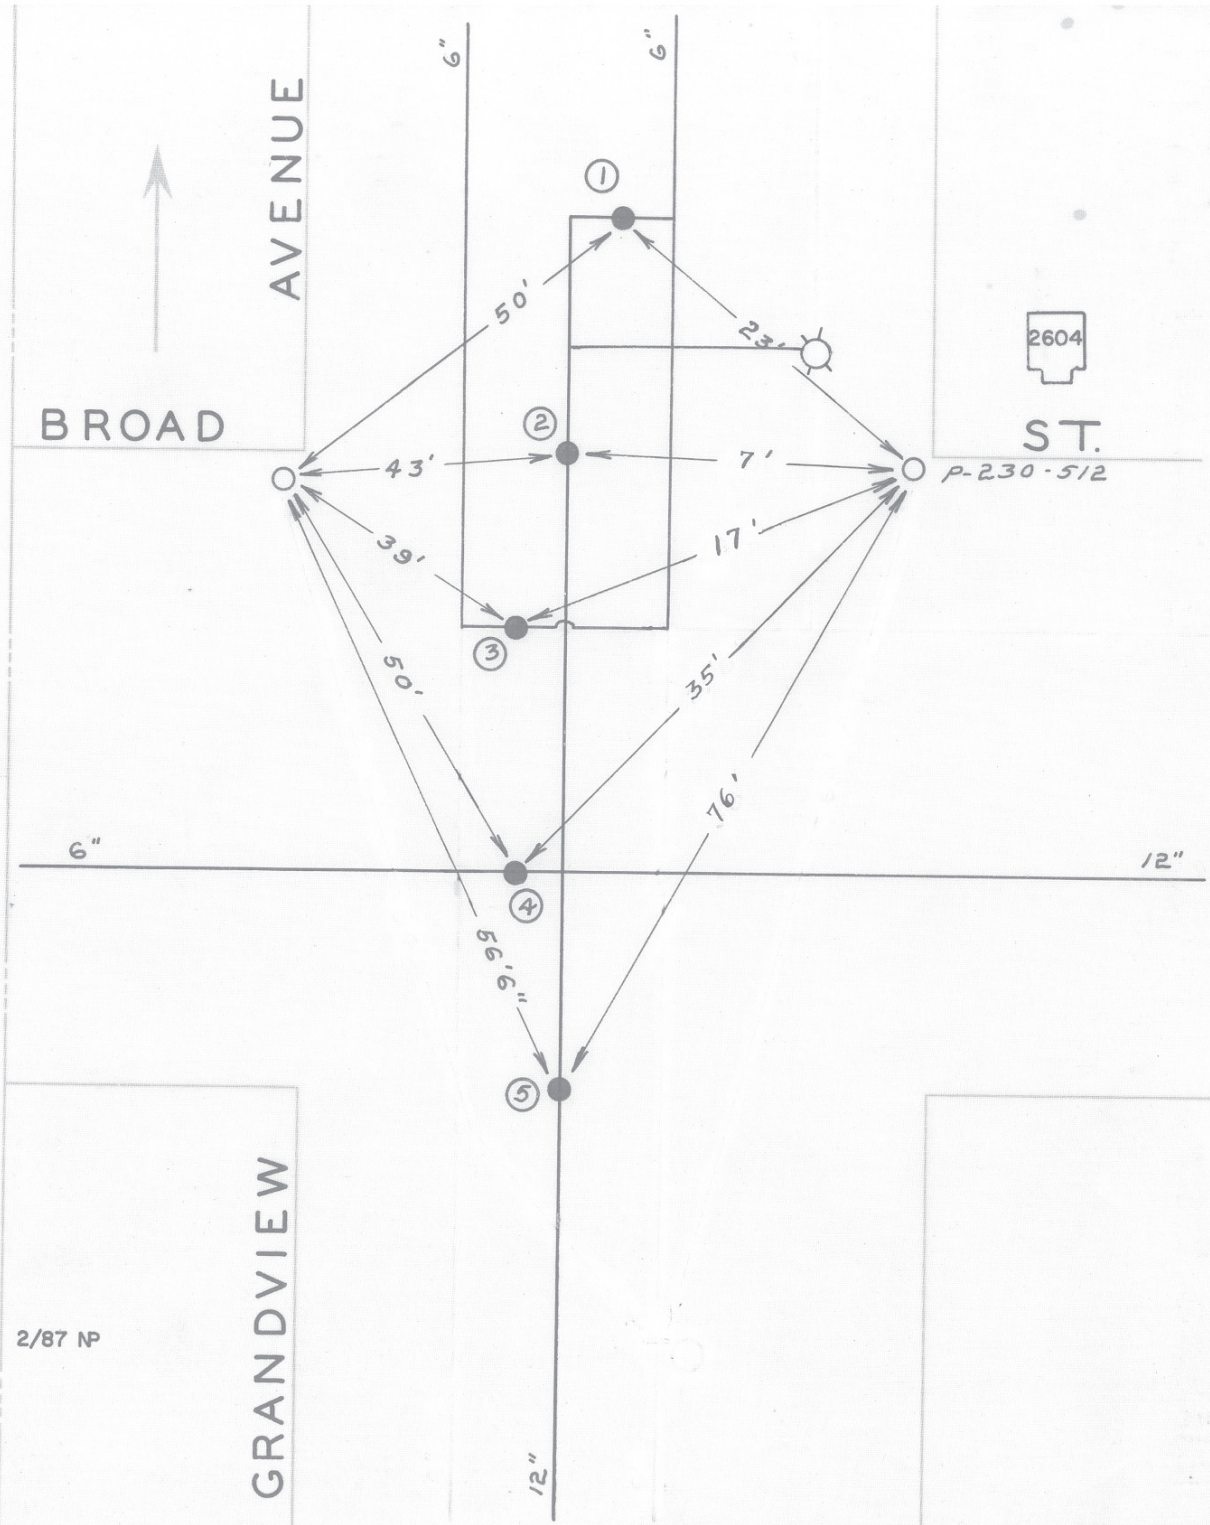

DATE	NO.	SIZE	MAKE	OPEN	TURNS
1952	1	6"			
1952	2	6"			
1951	3	6"			
1956	4	6"			
1952	5	12"			
	1	24'-N	NPL		
	2	0	NPL		
	3	8'-S	NPL		
	4	10'-N	SPL		
	5	0	SPL		

2/87 NP

CITY OF ROANOKE—WATER DEP'T

VALVE DIAGRAM

BROAD STREET &

GRANDVIEW AVE. N.W.

SEC. MAP 216

DATE PAGE NO.