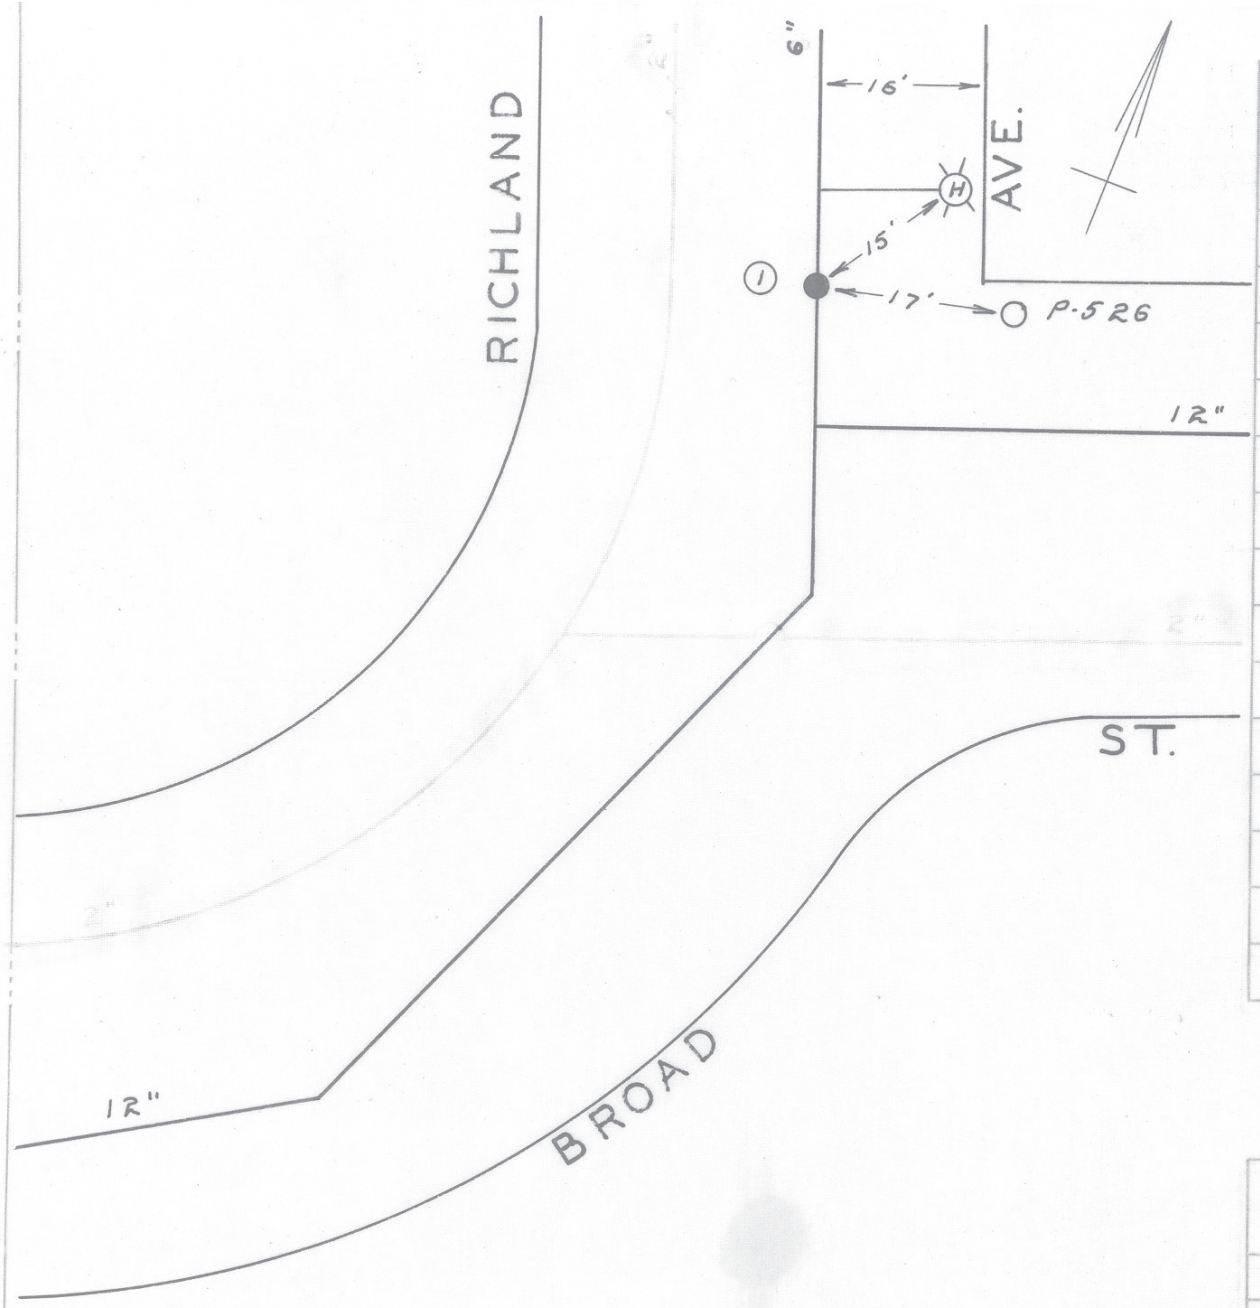

DATE	NO.	SIZE	MAKE	OPEN	TURNS
10-'52	1	6"	MUELLER	R	20
	1	0	NPL		

2/87 NP

CITY OF ROANOKE—WATER DEPT.

VALVE DIAGRAM

BROAD ST. & RICHLAND AVE. N. W.

SEC. MAP 216

DATE PAGE NO.

"IMPERIAL" TRACING CLOTH K & E CO., N. Y.