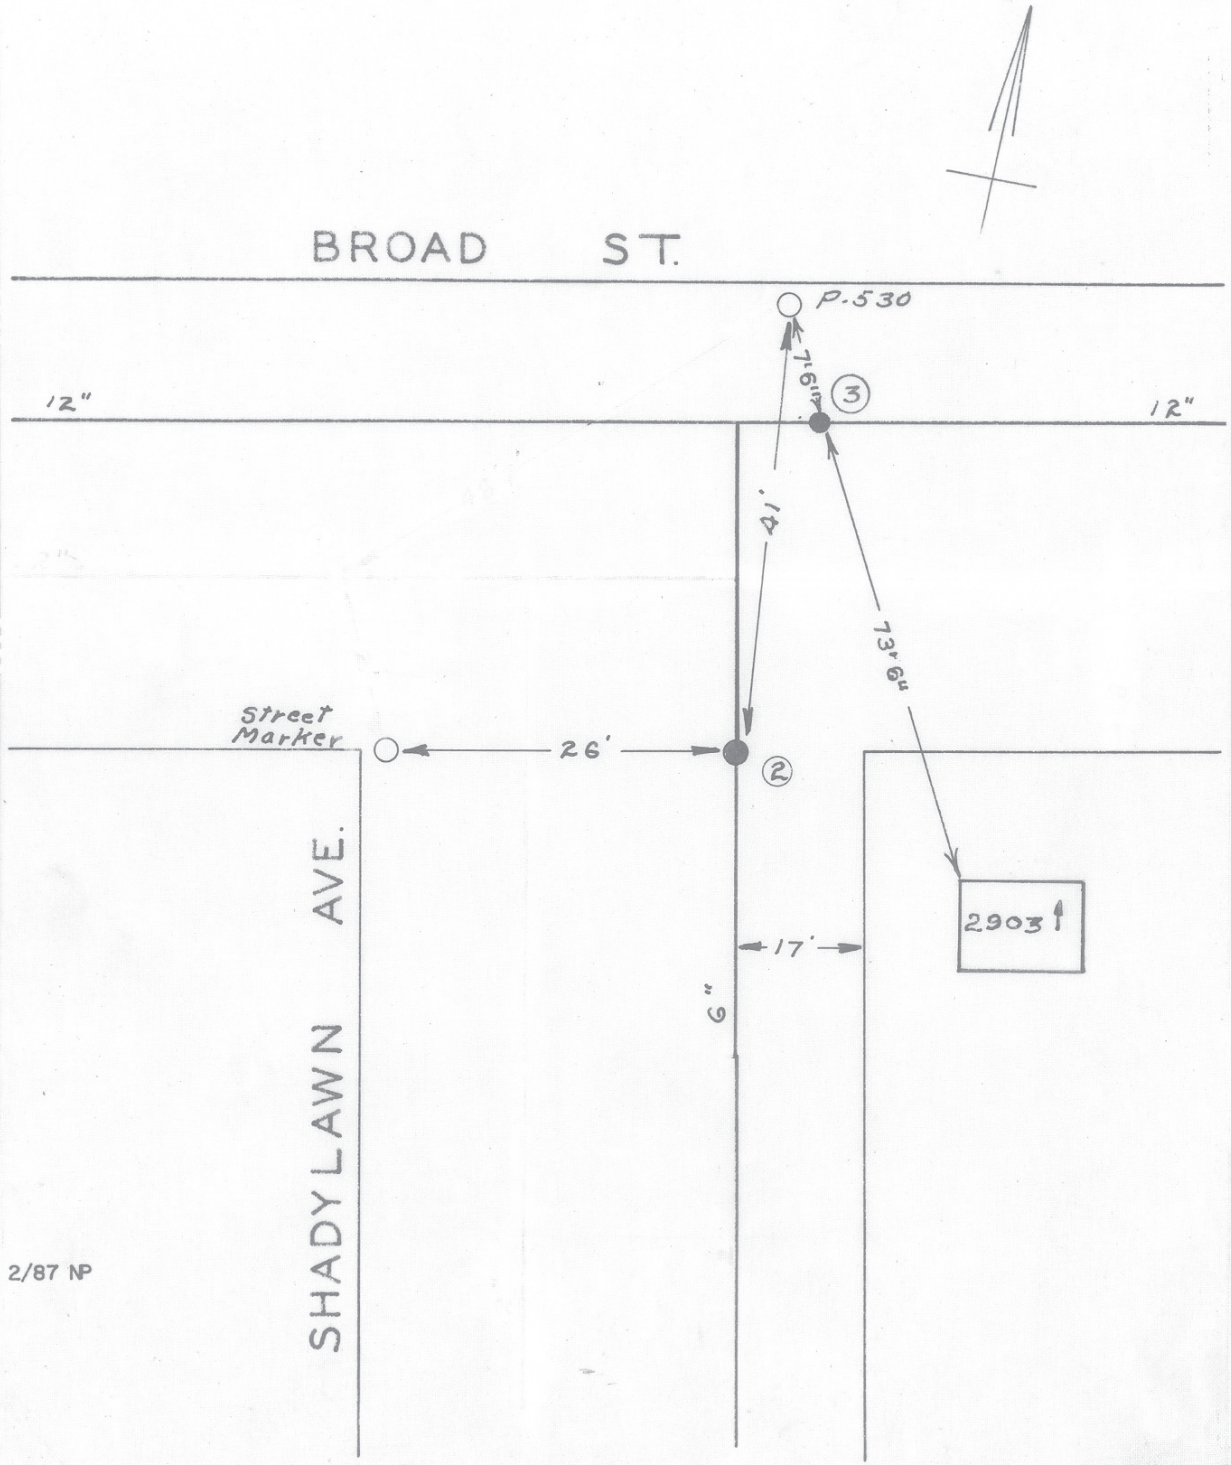

DATE	NO.	SIZE	MAKE	OPEN	TURNS
10-52	2	6"	MUELLER	R	20
6-62	3	12"	MUELLER	R	
	2	0	SPL		

CITY OF ROANOKE—WATER DEPT.

VALVE DIAGRAM

BROAD ST. & SHADYLAWN AVE. N. W.

SEC. MAP 216

DATE PAGE NO.

"IMPERIAL" TRACING CLOTH K & E CO., N. Y.