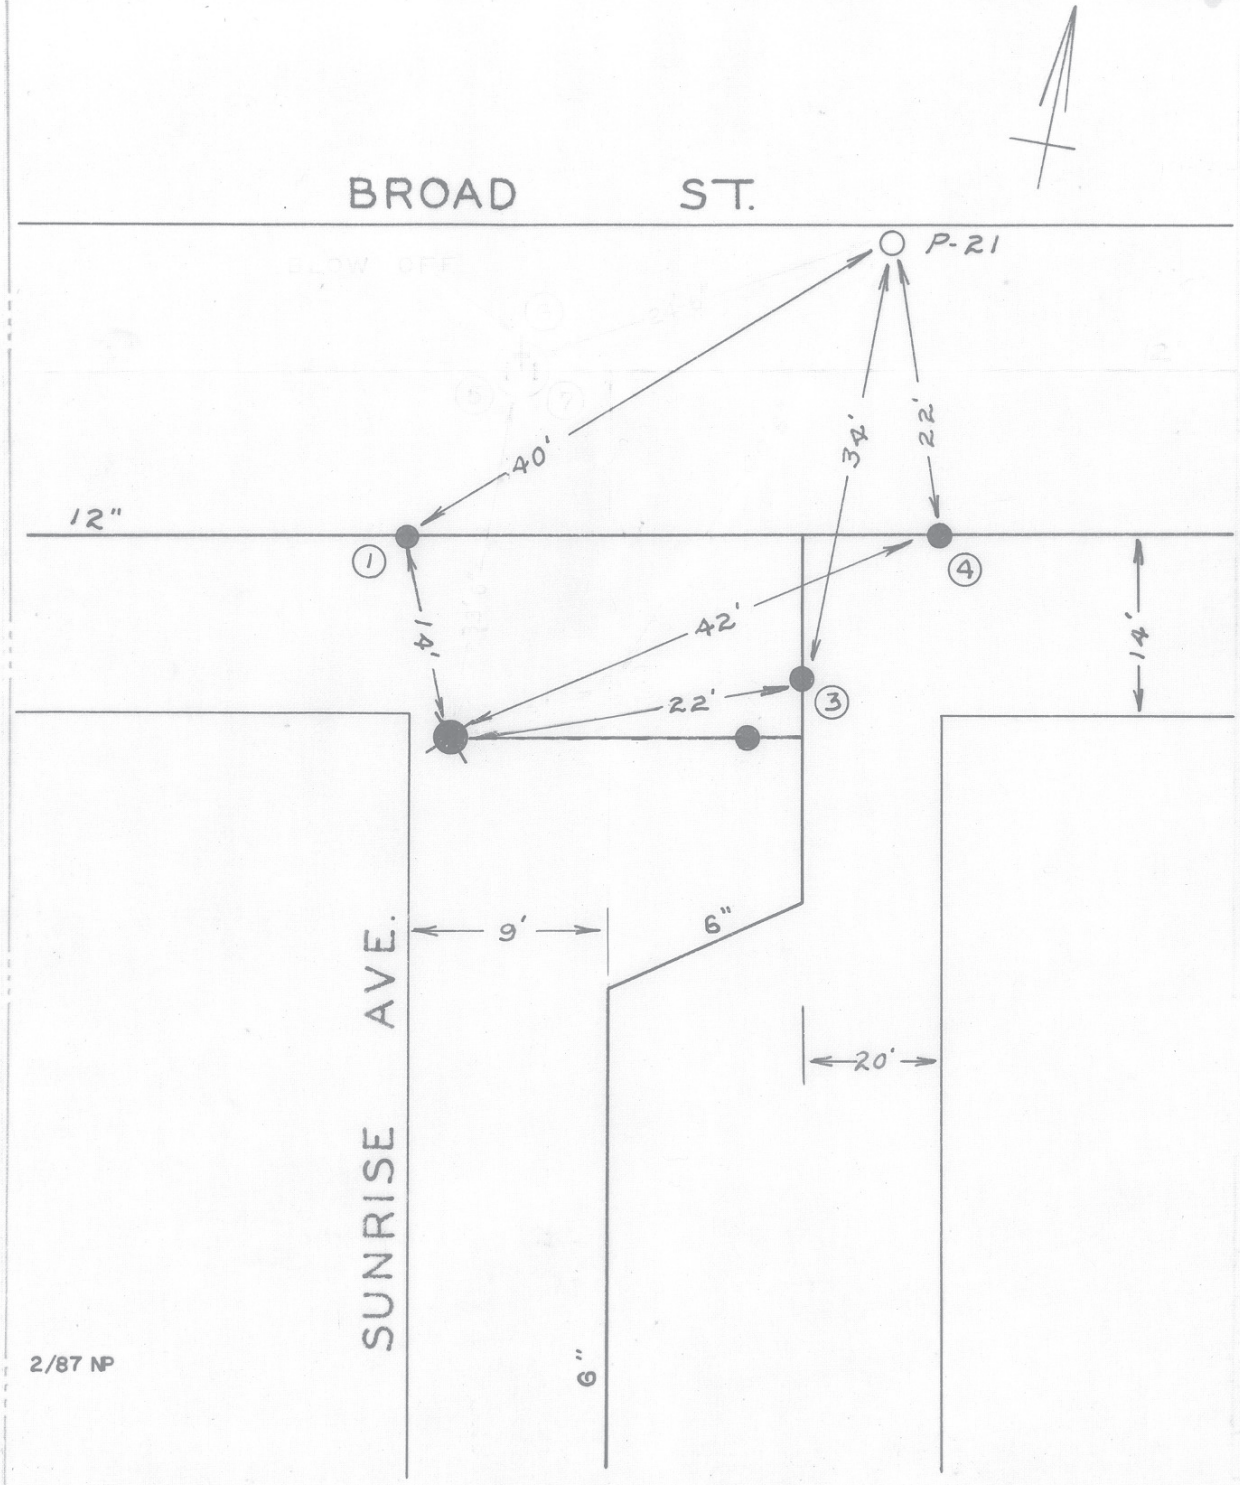

DATE	NO.	SIZE	MAKE	OPEN	TURNS
10-'52	1	12"	MUELLER	R	38
1-'53	3	6"	MUELLER	R	20
10-'52	4	12"	MUELLER	R	38
82	5	2"	MISC.	L	
82	6	2"	MISC.	L	
82	7	2"	MISC.	L	
	1	0	WPL		
	2				
	3	4'-N	SPL		
	4	0	EPL		

CITY OF ROANOKE — WATER DEPT.

VALVE DIAGRAM

BROAD ST. & SUNRISE AVE.

N. W.

SEC. MAP 216

DATE PAGE NO.

2/87 NP

"IMPERIAL" TRACING CLOTH
© K & E CO., N. Y.