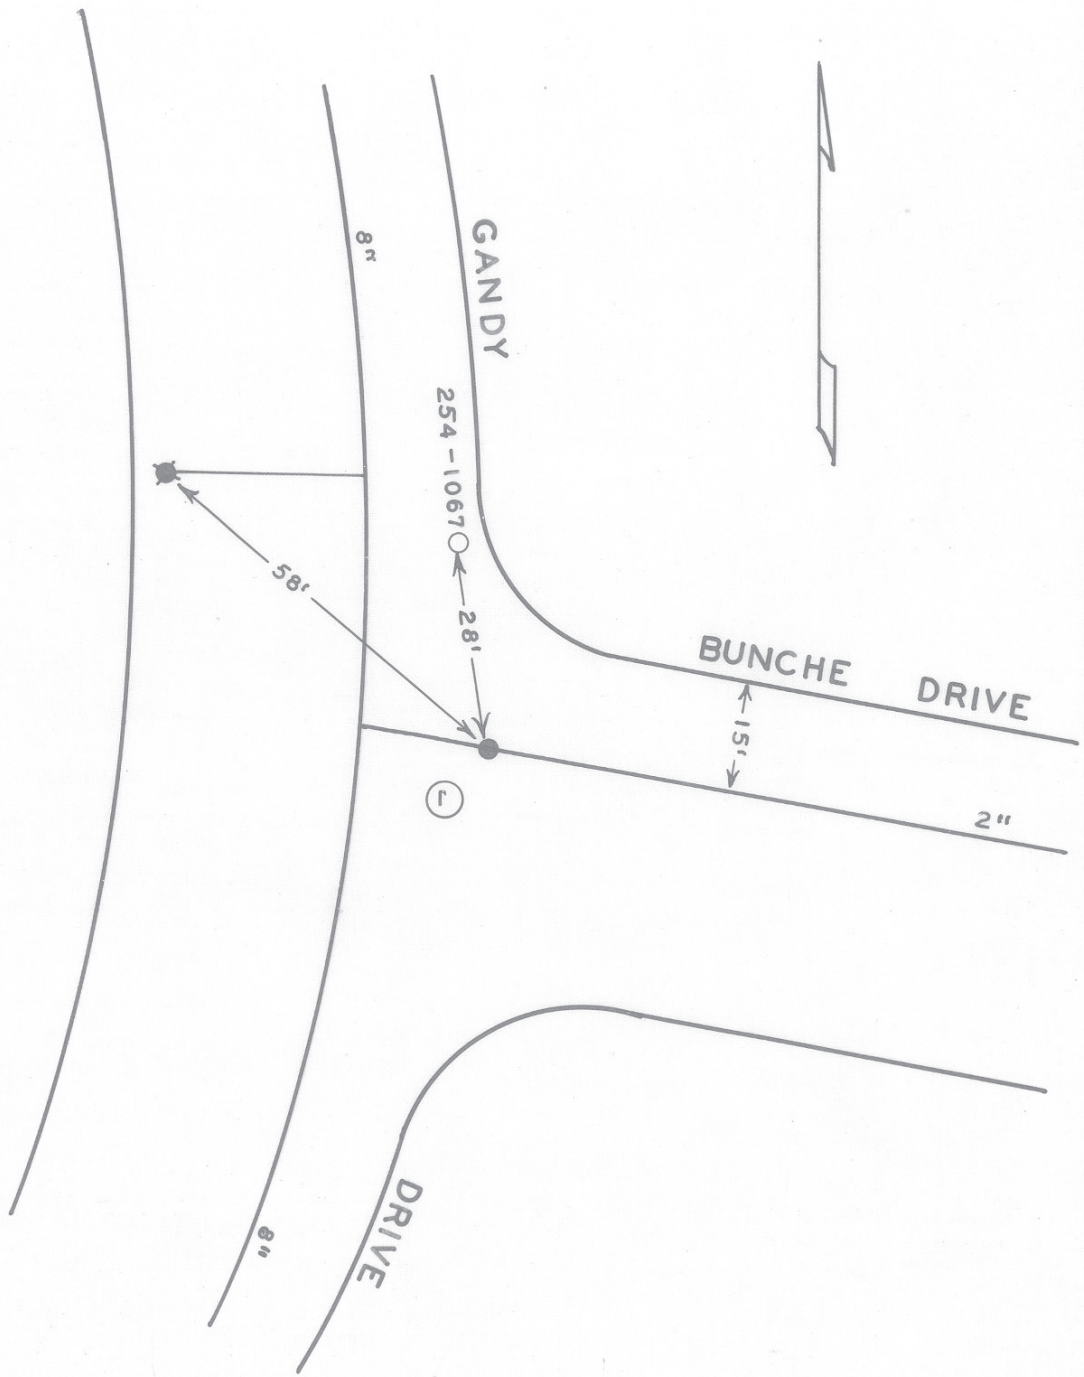

DATE	NO.	SIZE	MAKE	OPEN	TURNS
11-63	1	2"	DARLING	R	
	1	0	E.P.L.		

CITY OF ROANOKE — WATER DEPT.

VALVE DIAGRAM

BUNCHE DRIVE &
GANDY DRIVE N.W.

SEC. MAP 204

DATE PAGE NO.

2/87 NP