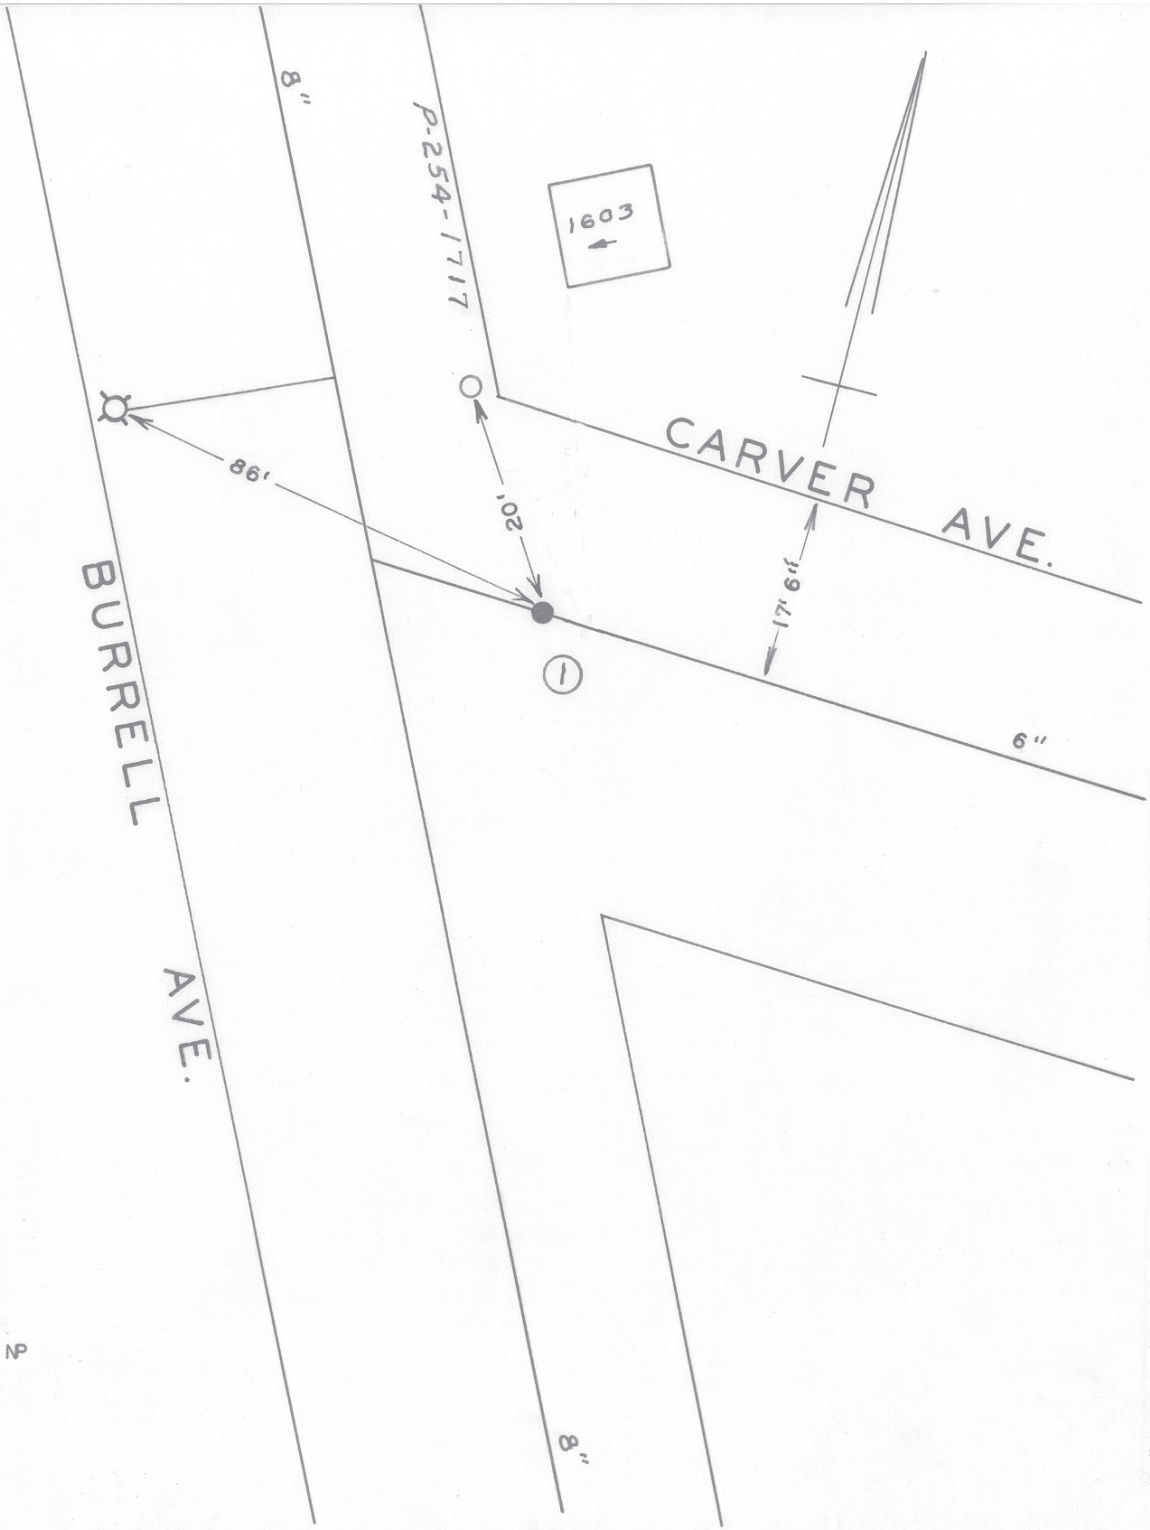

DATE	NO.	SIZE	MAKE	OPEN	TURNS
1-65	1	6"	MUELLER	R	
	1	0	EPL		

CITY OF ROANOKE—WATER DEPT.

VALVE DIAGRAM

BURRELL AVE. &

CARVER AVE. N.W.

SEC. MAP 204

DATE PAGE NO.

2/87 NP

"IMPERIAL" TRACING CLOTH. K & E CO., N. Y.