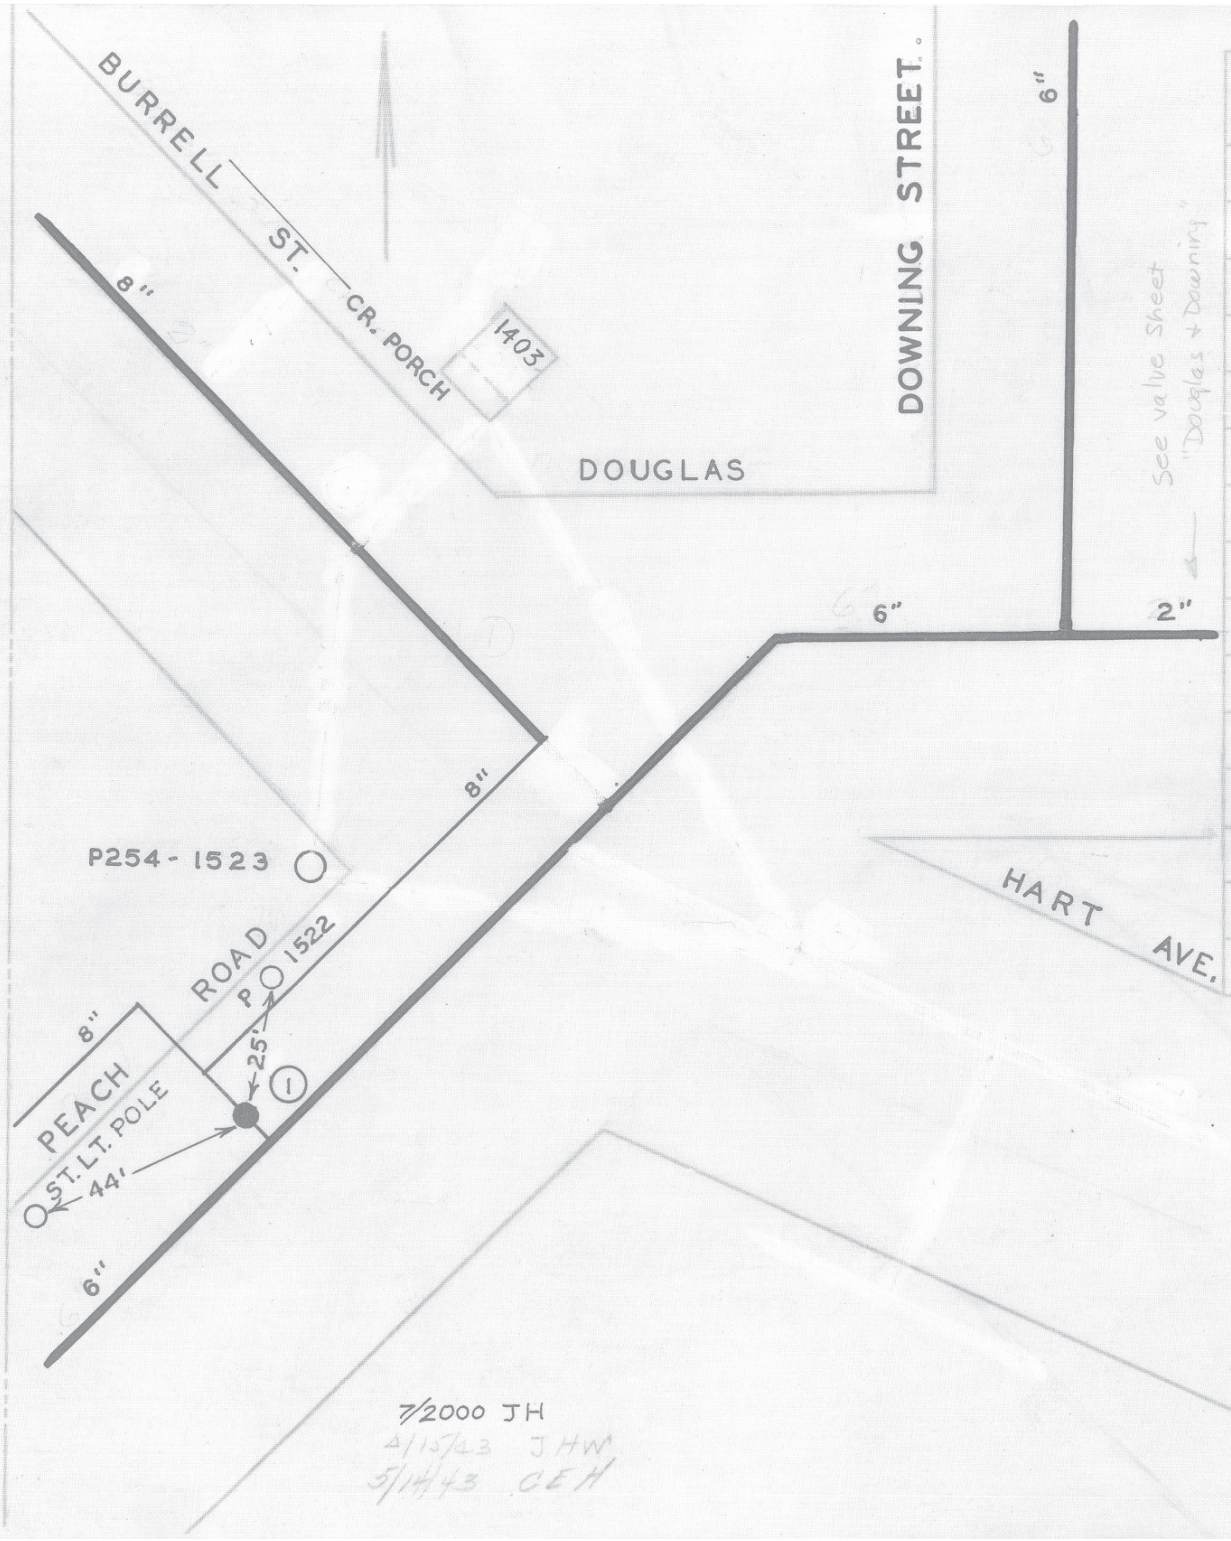


| DATE | NO. | SIZE | MAKE | OPEN | TURNS |
|---|---|---|---|---|---|
| 1949 | 1 | 8" | | R | 20 |
| | | | | | |

CITY OF ROANOKE—WATER DEP'T

VALVE DIAGRAM

BURRELL ST, DOWNING ST. HART AVE, PEACH ROAD & DOUGLAS AVE. N.W.

SEC. MAP 202

DATE

PAGE NO. NW.48

2187