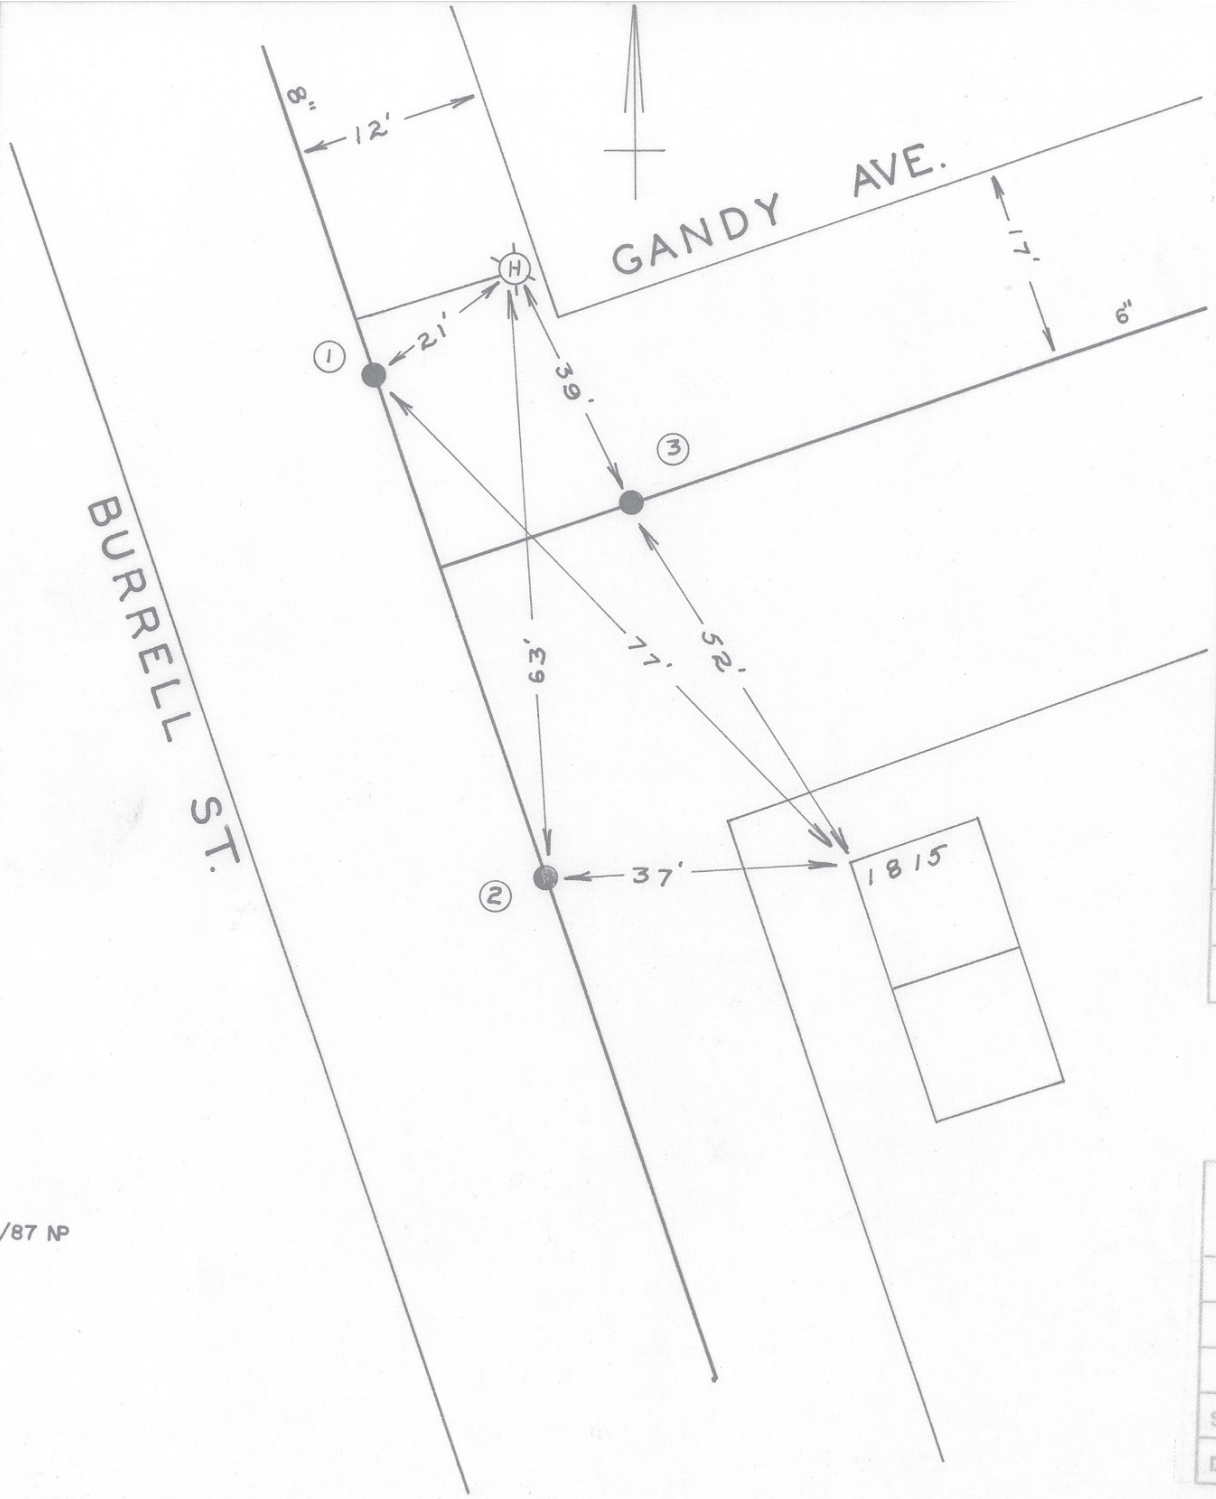


| DATE | NO. | SIZE | MAKE | OPEN | TURNS |
|---|---|---|---|---|---|
| 1952 | 1 | 8" | MUELLER | | |
| 1952 | 2 | 8" | MUELLER | | |
| 1952 | 3 | 6" | MUELLER | | |
| | | | | | |
| | | | | | |
| | | | | | |
| | | | | | |
| | | | | | |
| | | | | | |
| | | | | | |
| | | | | | |
| | 1 | 0 | NPL | | |
| | 2 | 0 | SPL | | |
| | 3 | 0 | EPL | | |
| | | | | | |

2/87 NP

"IMPERIAL" TRACING CLOTH
K & E CO., N. Y.

CITY OF ROANOKE — WATER DEPT.

VALVE DIAGRAM

BURRELL ST. & GANDY AVE. N. W.

SEC. MAP 204

DATE PAGE NO.