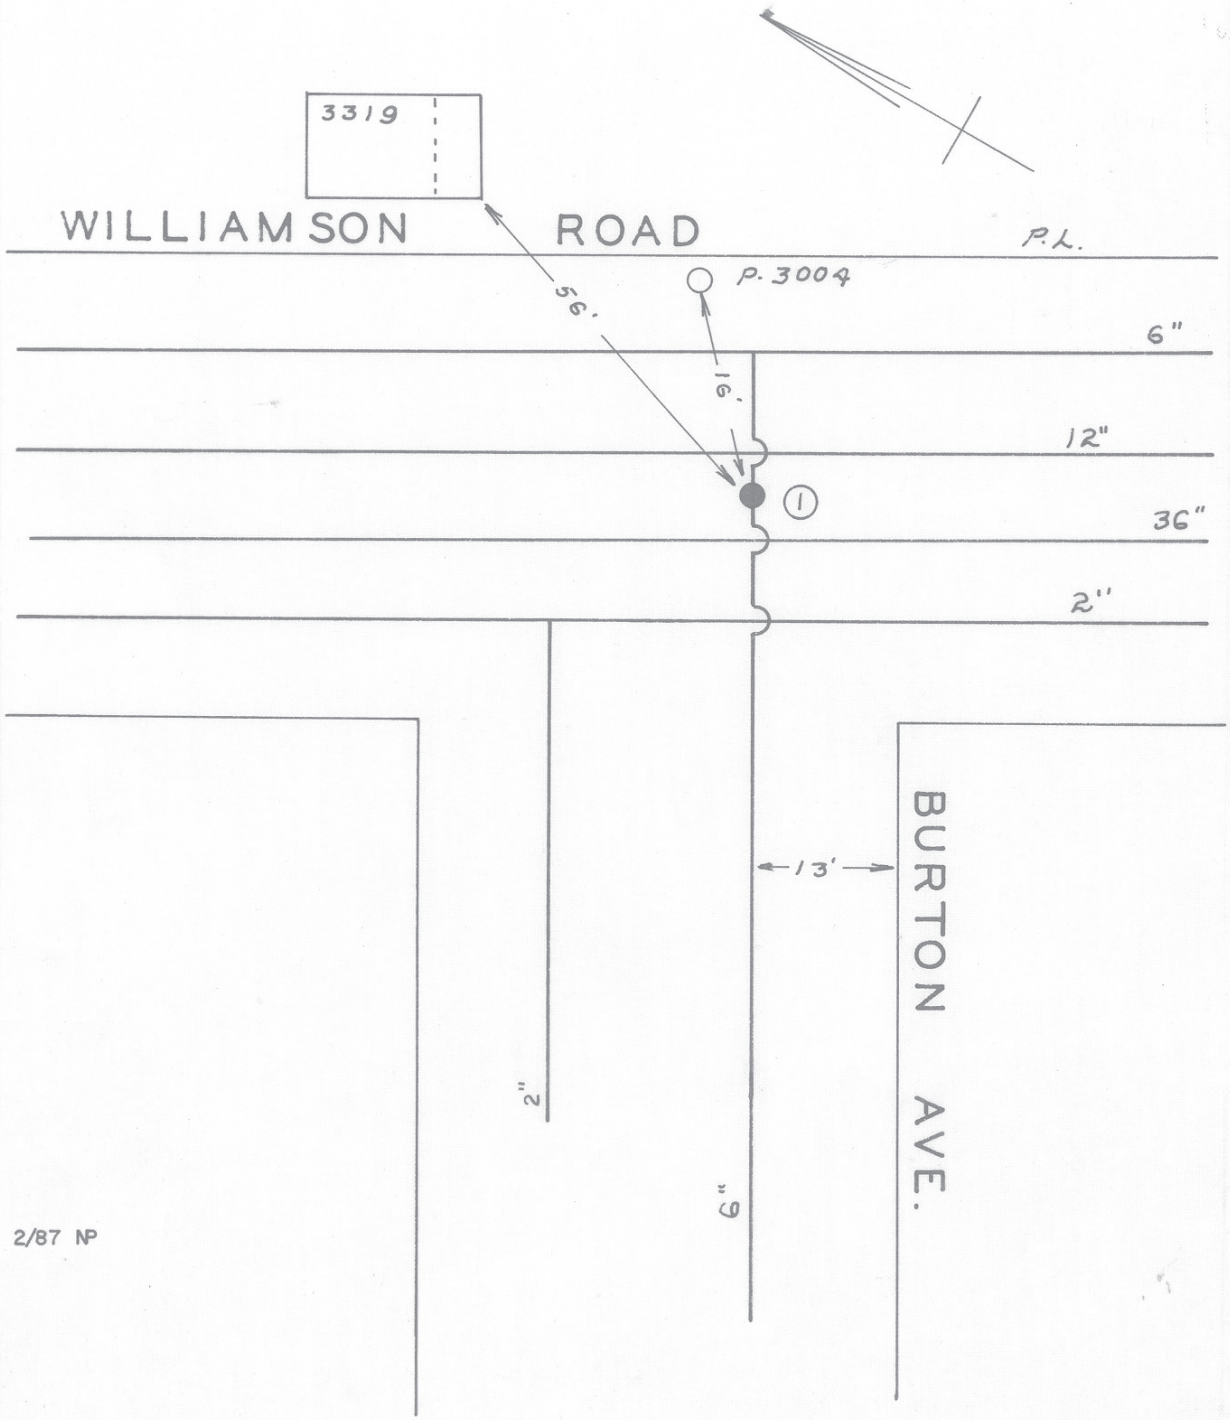

DATE	NO.	SIZE	MAKE	OPEN	TURNS
WR 1951	1	6"			
	1	18'-W	EPL		

2/87 NP

CITY OF ROANOKE—WATER DEPT.

VALVE DIAGRAM

BURTON AVE. & WILLIAMSON ROAD

SEC. MAP 208 N.W.

DATE PAGE NO.

"IMPERIAL" TRACING CLOTH. K & E CO., N. Y.