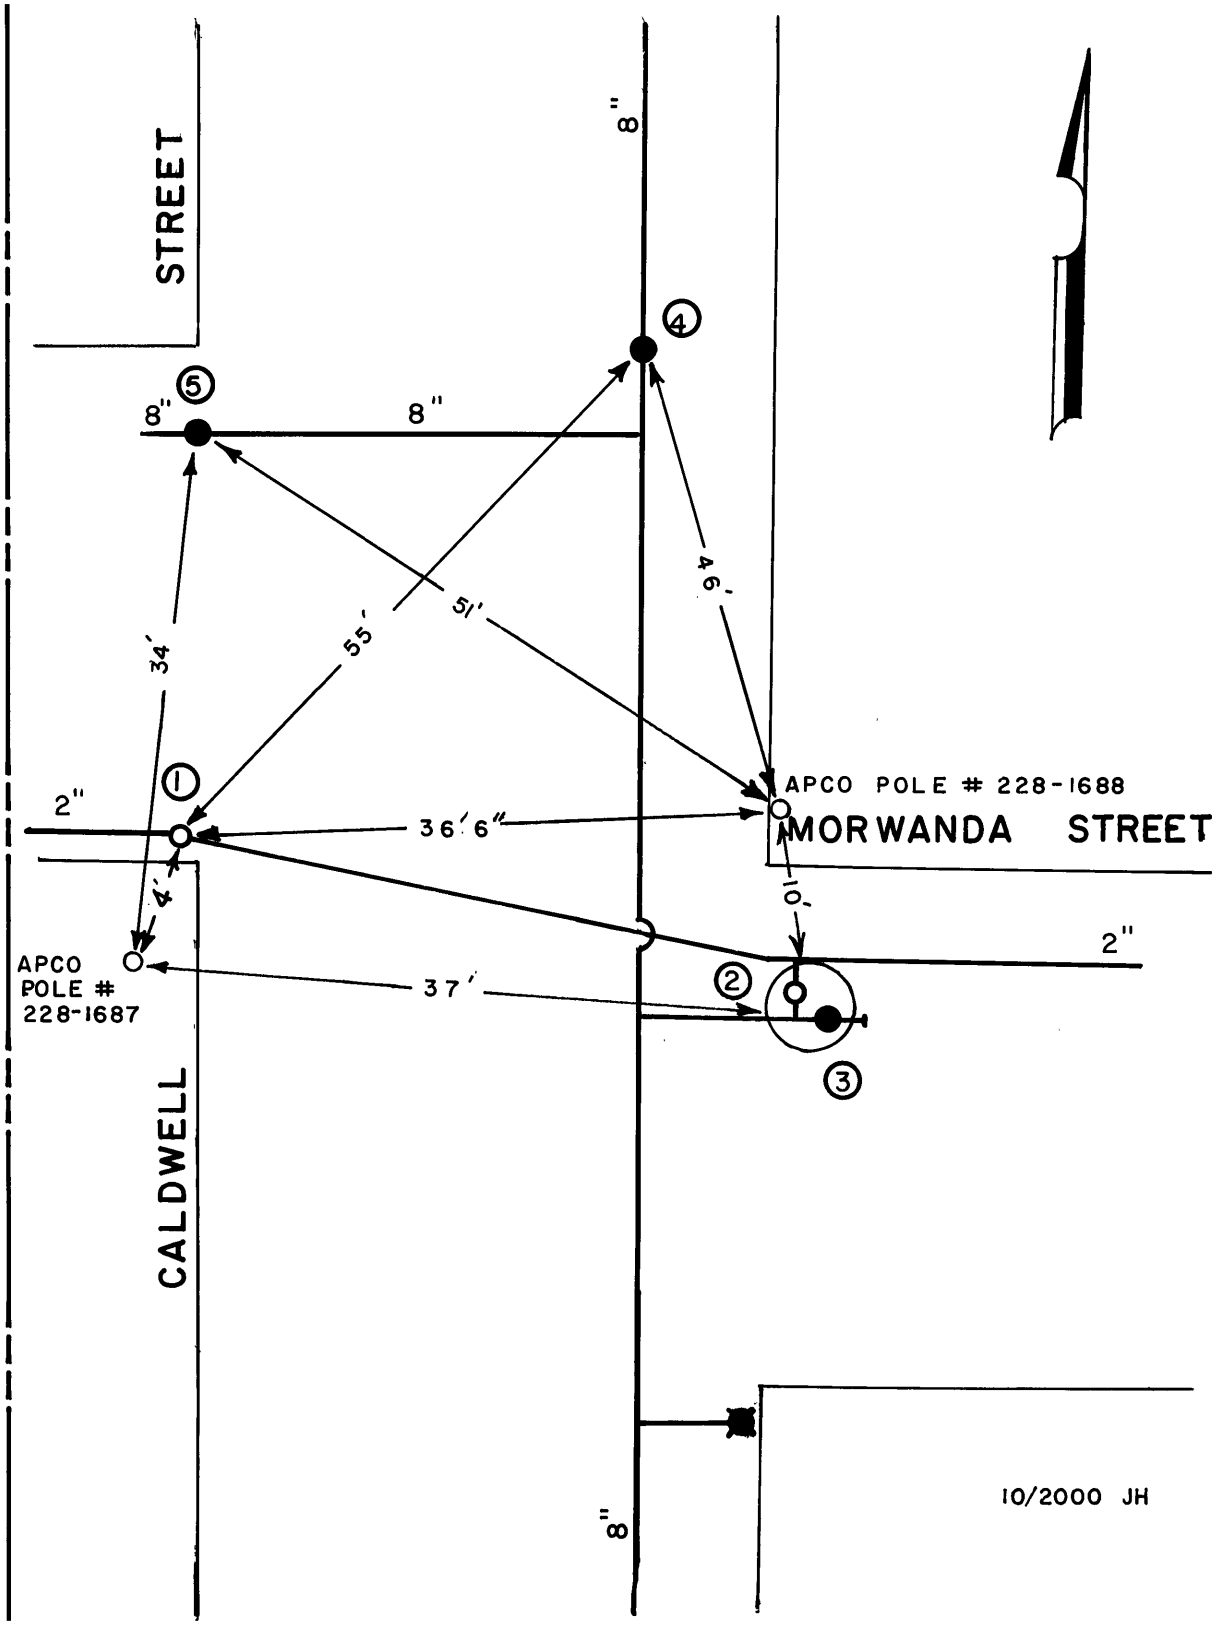


| DATE | NO. | SIZE | MAKE | OPEN | TURNS |
|---|---|---|---|---|---|
| 1977 | 1 | 2" | MISC. | L | |
| 1977 | 2 | 2" | MISC. | L | |
| 1977 | 3 | 8" | MUELLER | R | 26 |
| 1977 | 4 | 8" | MUELLER | R | 26 |
| 1977 | 5 | 8" | MUELLER | R | 26 |
| | | | | | |
| | | | | | |
CITY OF ROANOKE - WATER DEP'T.

# VALVE DIAGRAM

CALDWELL STREET &
MORWANDA STREET

SEC. MAP 608 N.W.

DATE: PAGE NO.