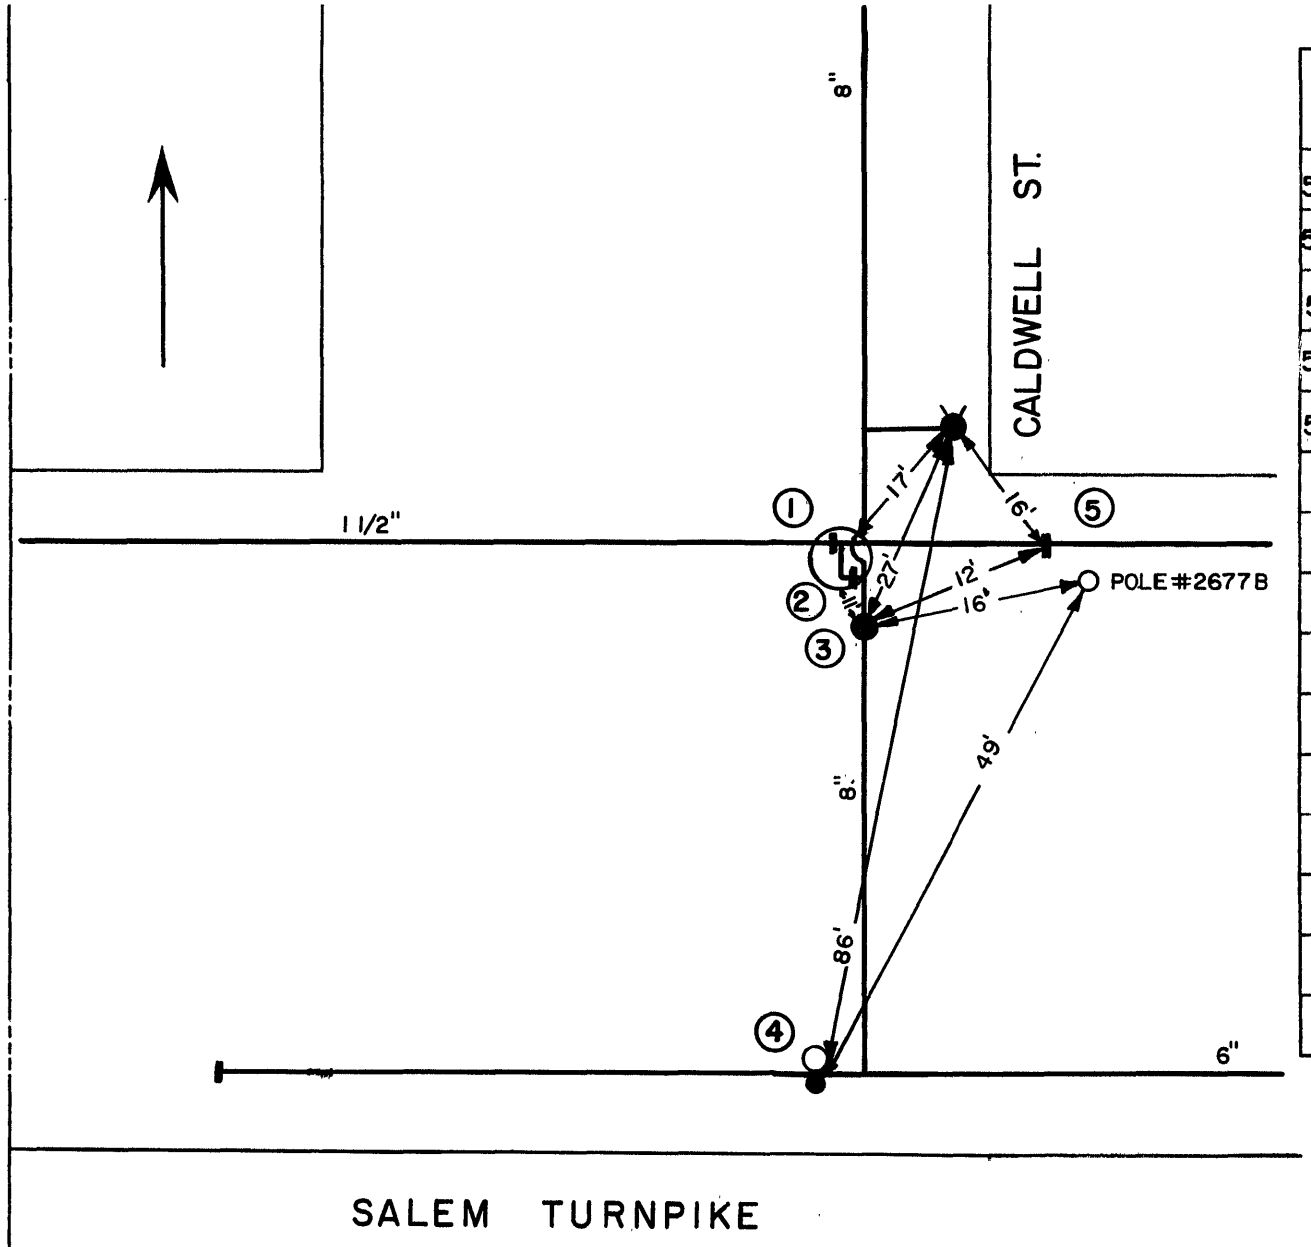

DATE	NO.	SIZE	MAKE	OPEN	TURNS
5-77	1	1 1/2"	MISC.	L	
5-77	2	1 1/2"	MISC.	L	
5-77	3	8"	MUELLER	R	
5-77	4	16"	BYPASS VALVE DARLING	R	
5-77	5	1 1/2"	MISC.	L	

1/87 NP
10/2000 JH

CITY OF ROANOKE—WATER DEP'T
VALVE DIAGRAM

CALDWELL STREET &
SALEM TURNPIKE

SEC. MAP 608 N. W.

DATE PAGE NO.