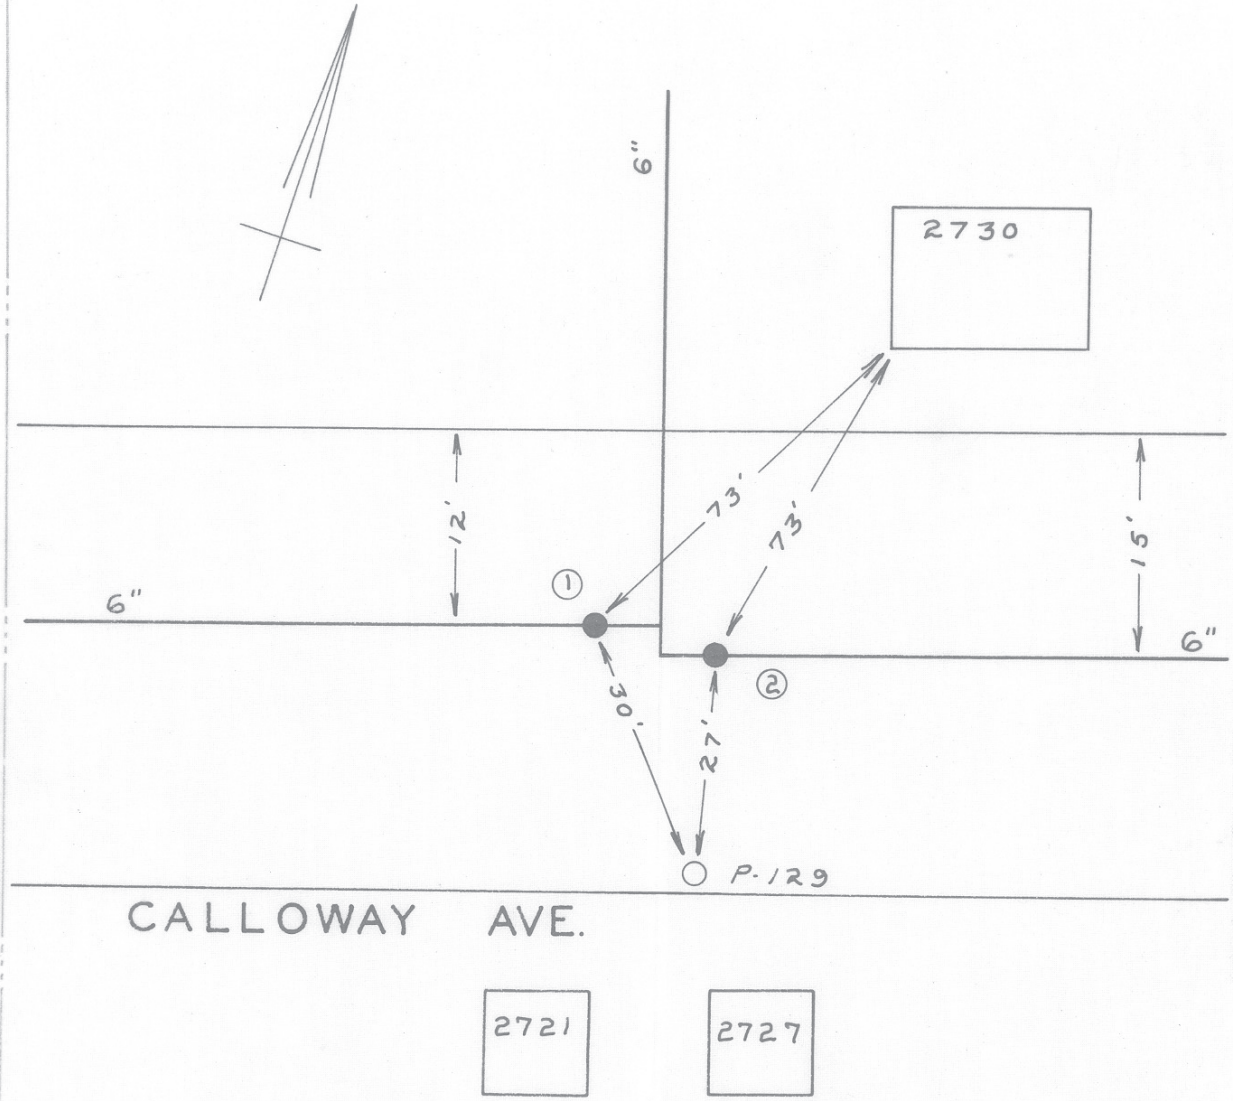

DATE	NO.	SIZE	MAKE	OPEN	TURNS
12-'52	1	6"			
1951	2	6"			
	1	418'-W	WPL	RICHLAND	
	2	415'-W	WPL	RICHLAND	

2/87 NP

CITY OF ROANOKE—WATER DEPT.

VALVE DIAGRAM

CALLOWAY AVE. 415'-WEST

OF RICHLAND AVE. N.W.

SEC. MAP 216

DATE PAGE NO.

"IMPERIAL" TRACING CLOTH. K & E CO., N. Y.