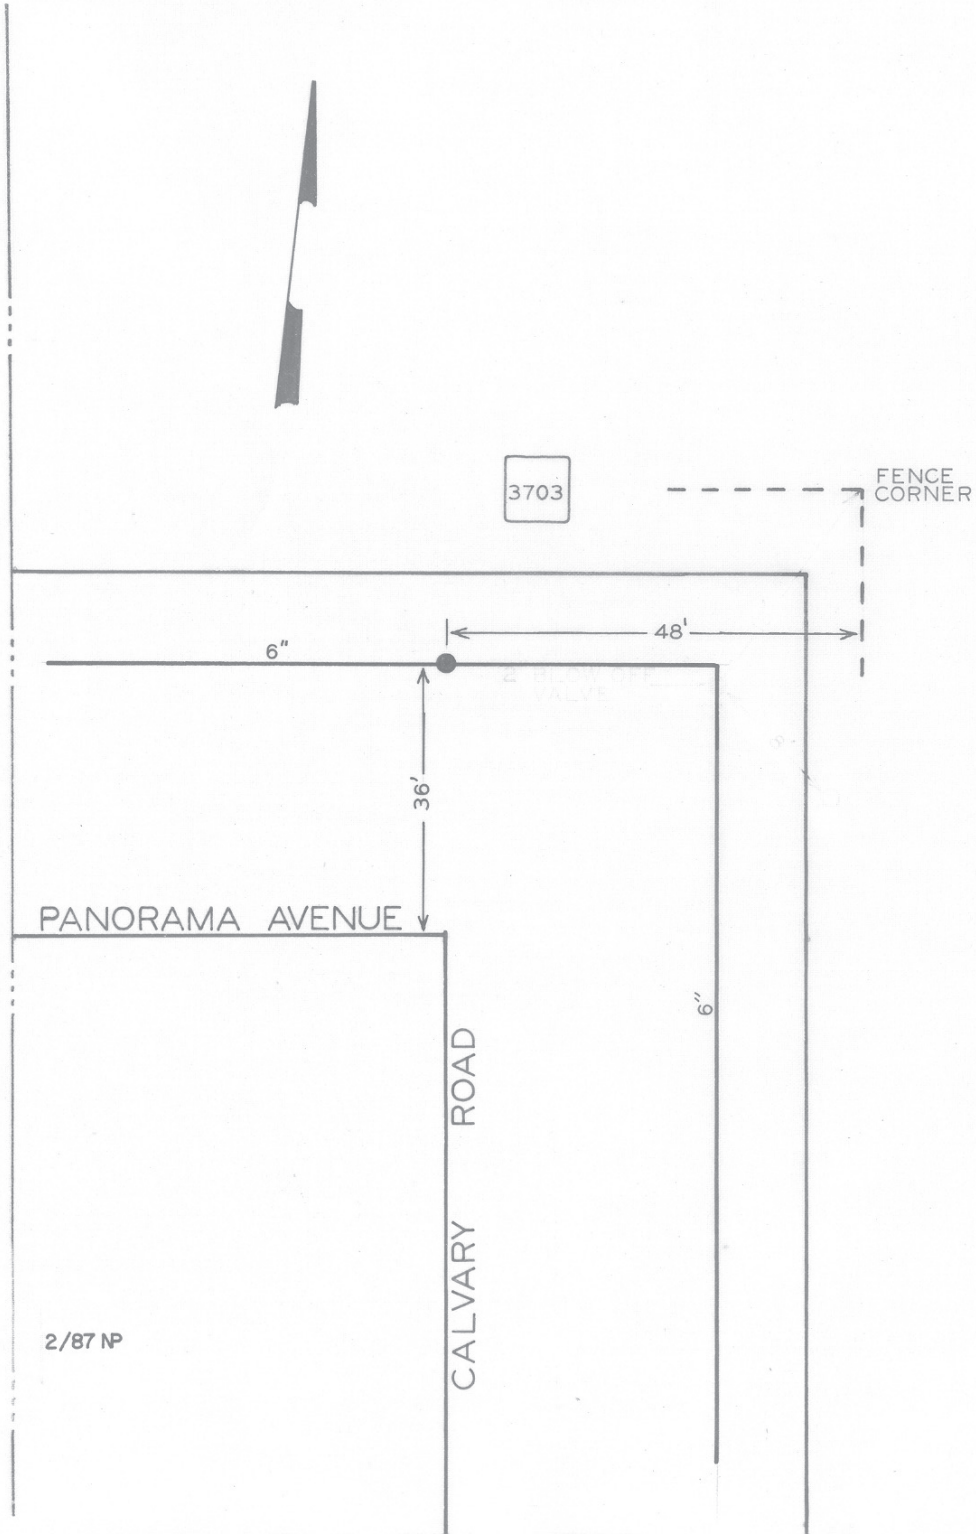

DATE	NO.	SIZE	MAKE	OPEN	TURNS
70	1	6"	MUELLER	R	

CITY OF ROANOKE — WATER DEPT.

VALVE DIAGRAM

CALVARY RD. N.W. &

PANORAMA AVENUE

SEC. MAP 265-74

DATE PAGE NO.