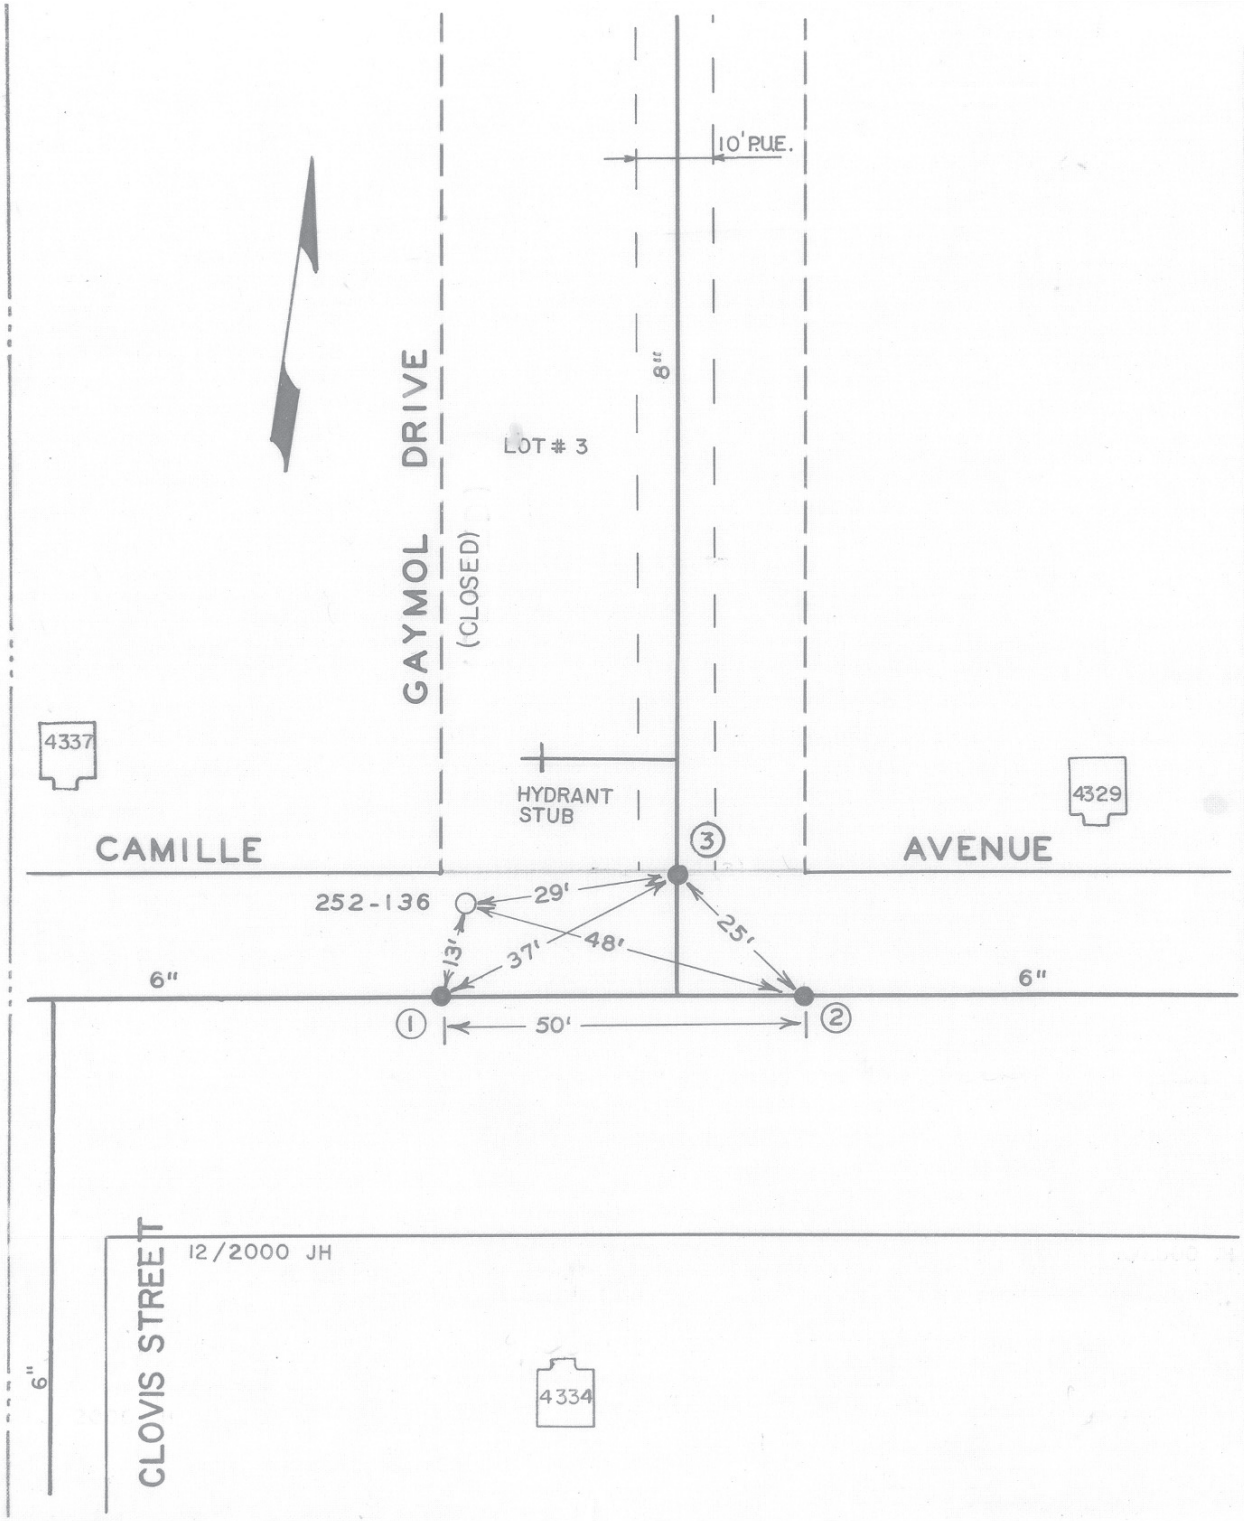

DATE	NO.	SIZE	MAKE	OPEN	TURNS
4-62	1	6"	MUELLER	R	20
4-62	2	6"	MUELLER	R	20
4-62	3	8"	MUELLER	R	26
	1	0	W.P.L.		
	2	0	E.P.L.		
	3	0	N.P.L.		

CITY OF ROANOKE — WATER DEPT.

VALVE DIAGRAM

CAMILLE AVENUE &

CLOVIS STREET &

GAYMOL DRIVE

SEC. MAP 605 N.W.

DATE PAGE NO.