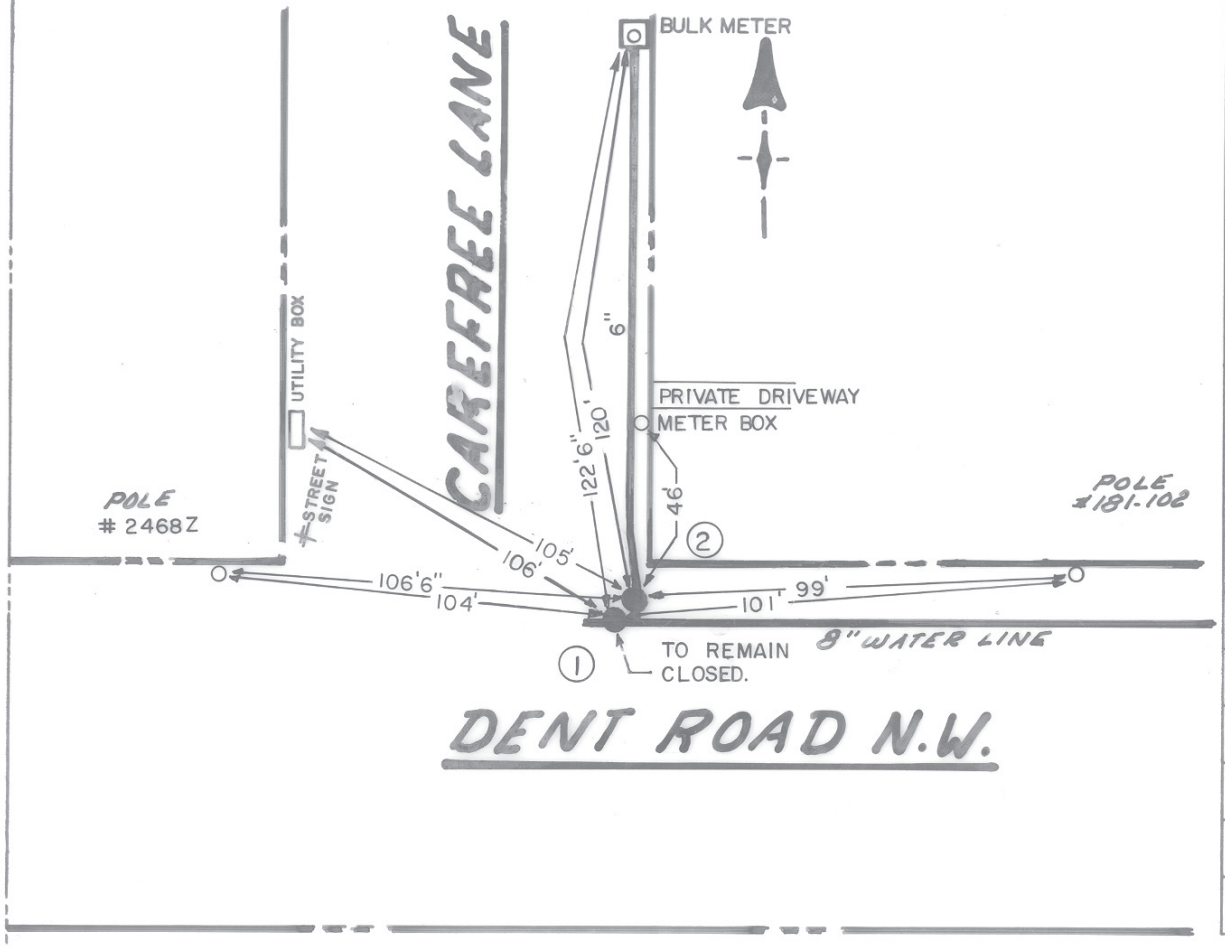

DATE	NO.	SIZE	MAKE	OPEN	TURNS
11-83	1	8"	KENNEDY	CLOSED R	27
11-85	2	6"		R	21

CITY OF ROANOKE—WATER DEP'T

VALVE DIAGRAM

CAREFREE LANE & DENT ROAD N.W. (1)

SEC. MAP COUNTY #3, 700

DATE 7-9-84 PAGE NO.

10/90 NP
5/97 NP