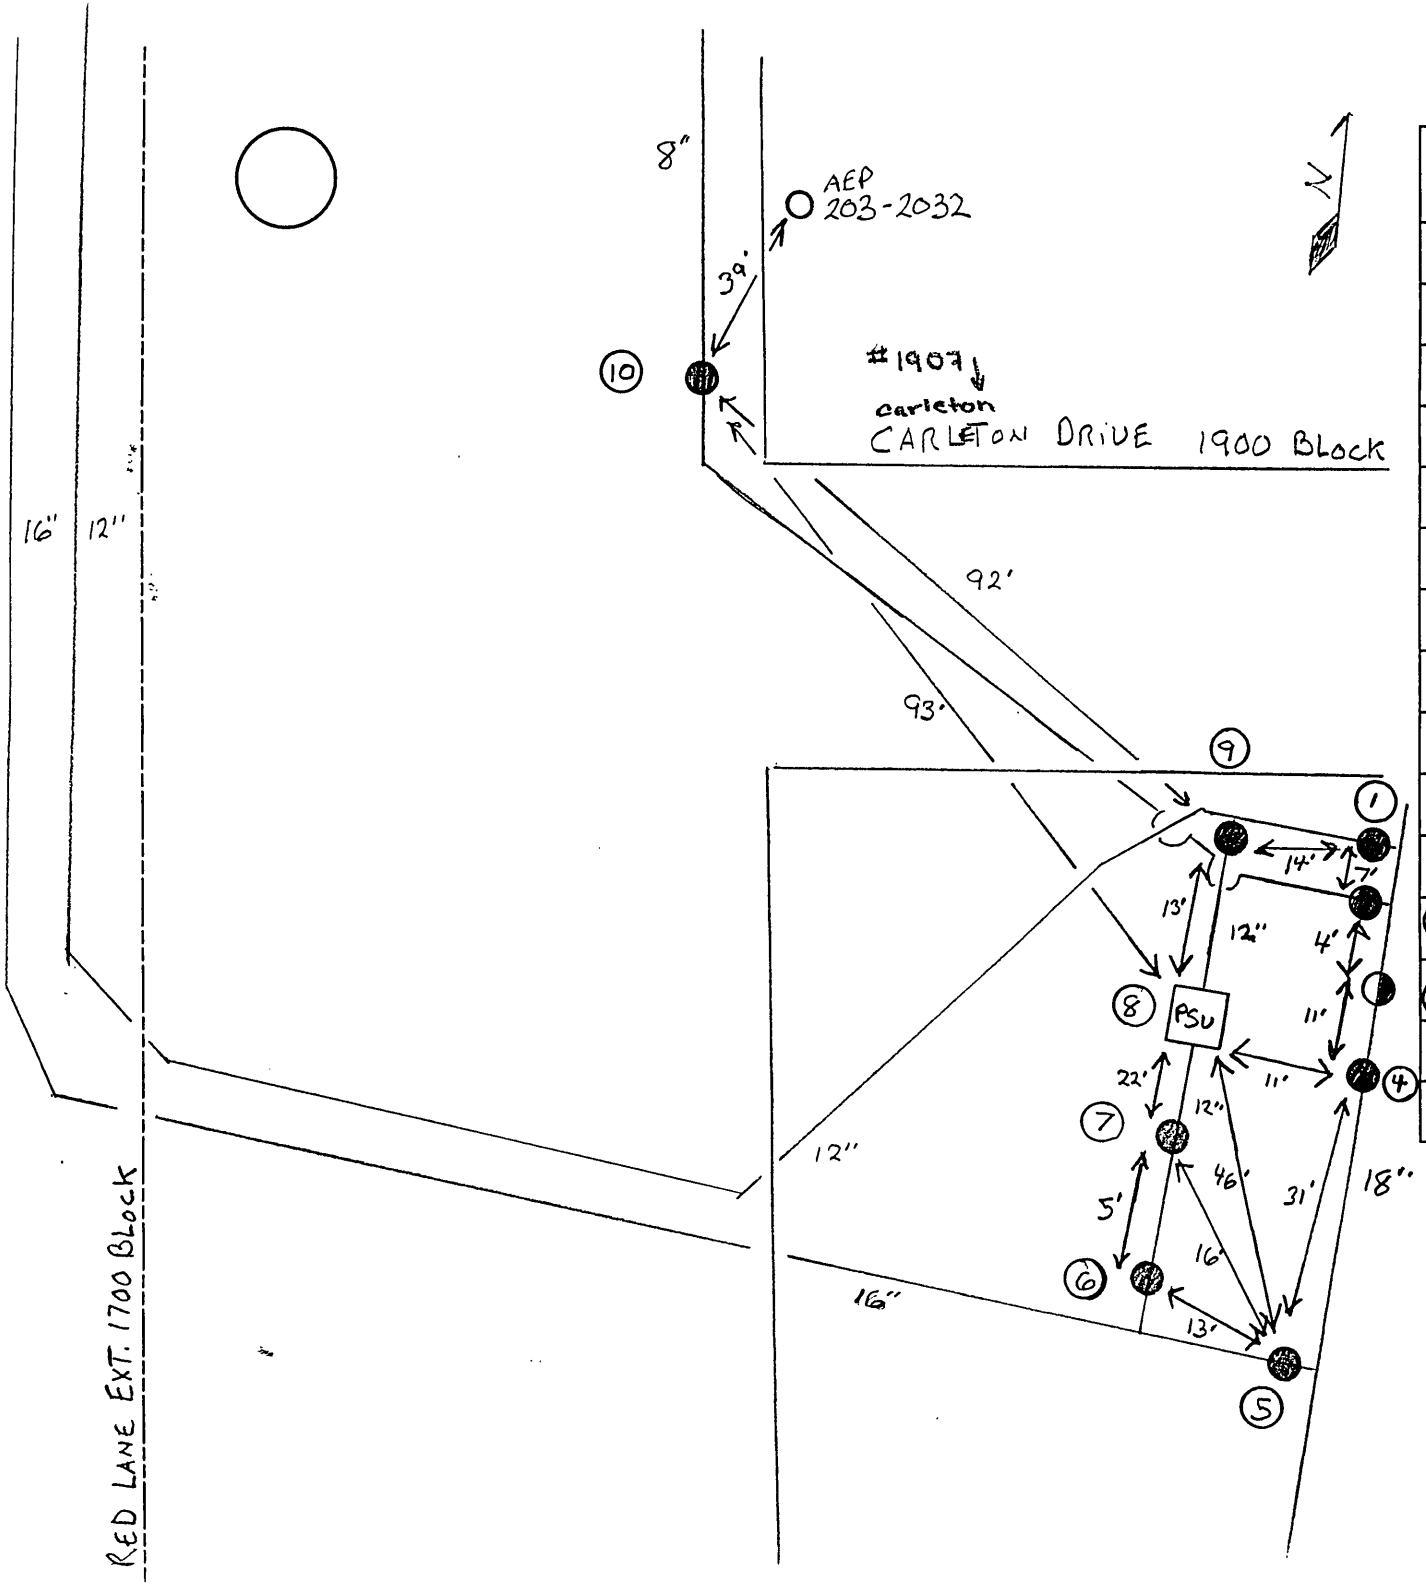

DATE	NO.	SIZE	MAKE	OPEN	TURNS
12/04	1	12"	AMERICAN	L	39
[illegible]	2	8"		L	27
	3	18"		L	
	4		AIR RELEASE		
12/04	5	16"	AMERICAN	L	105
12/04	6	12"	MUELLER	L	39
12/04	7	2"	AIR RELEASE		
12/04	8	12"	PSV		
12/04	9	12	MUELLER	L	39
	10		AIR RELEASE		
2					
3					

WESTERN VIRGINIA WATER AUTHORITY

VALVE DIAGRAM

RED LANE EXT AND
CARLETON DRIVE - 1910,
HANGING ROCK TERRACE

SECT. MAP NW COUNTY