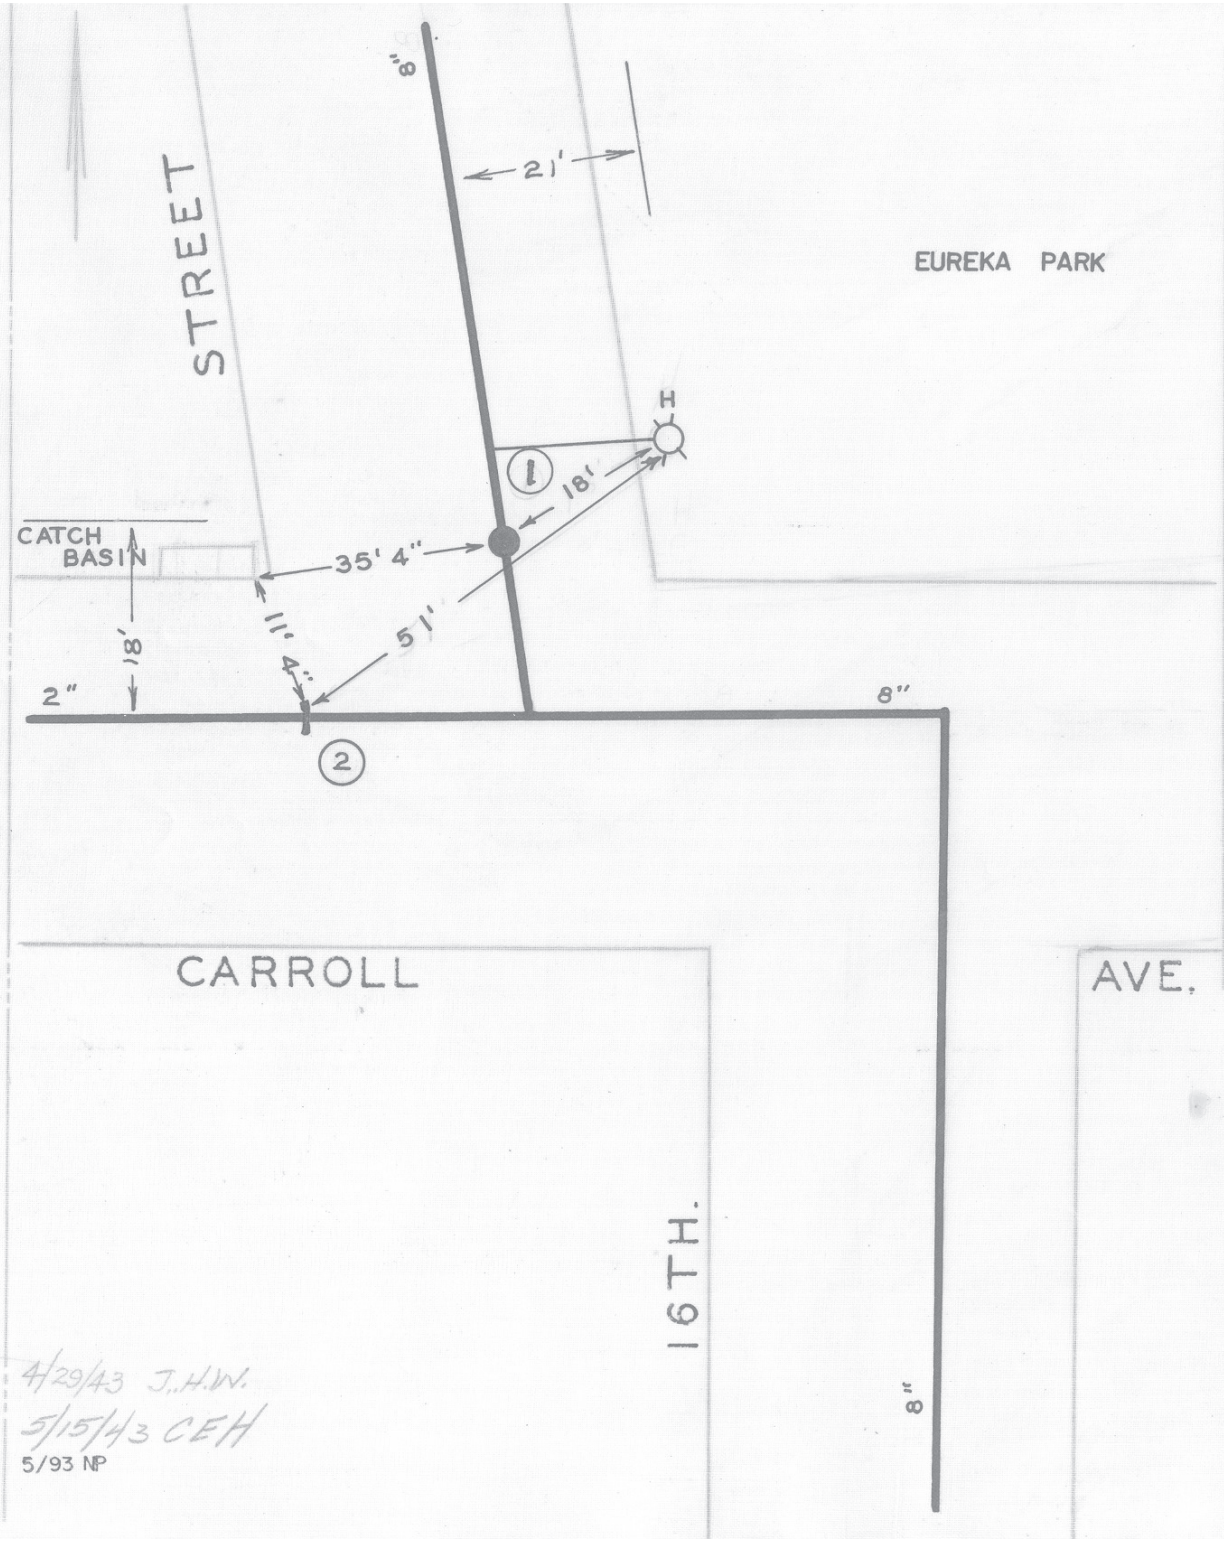

DATE	NO.	SIZE	MAKE	OPEN	TURNS
1939	1	8"		R	27
1935	2	2"		R	7
	1	0	NPL		
	2	3'-E	WPL		

CITY OF ROANOKE—WATER DEP'T

VALVE DIAGRAM

CARROLL AVE. & 16TH. ST. N.W.

SEC. MAP 233,223

DATE PAGE NO. NW 227

4/29/43 J.H.W.
5/15/43 CEH
5/93 NP