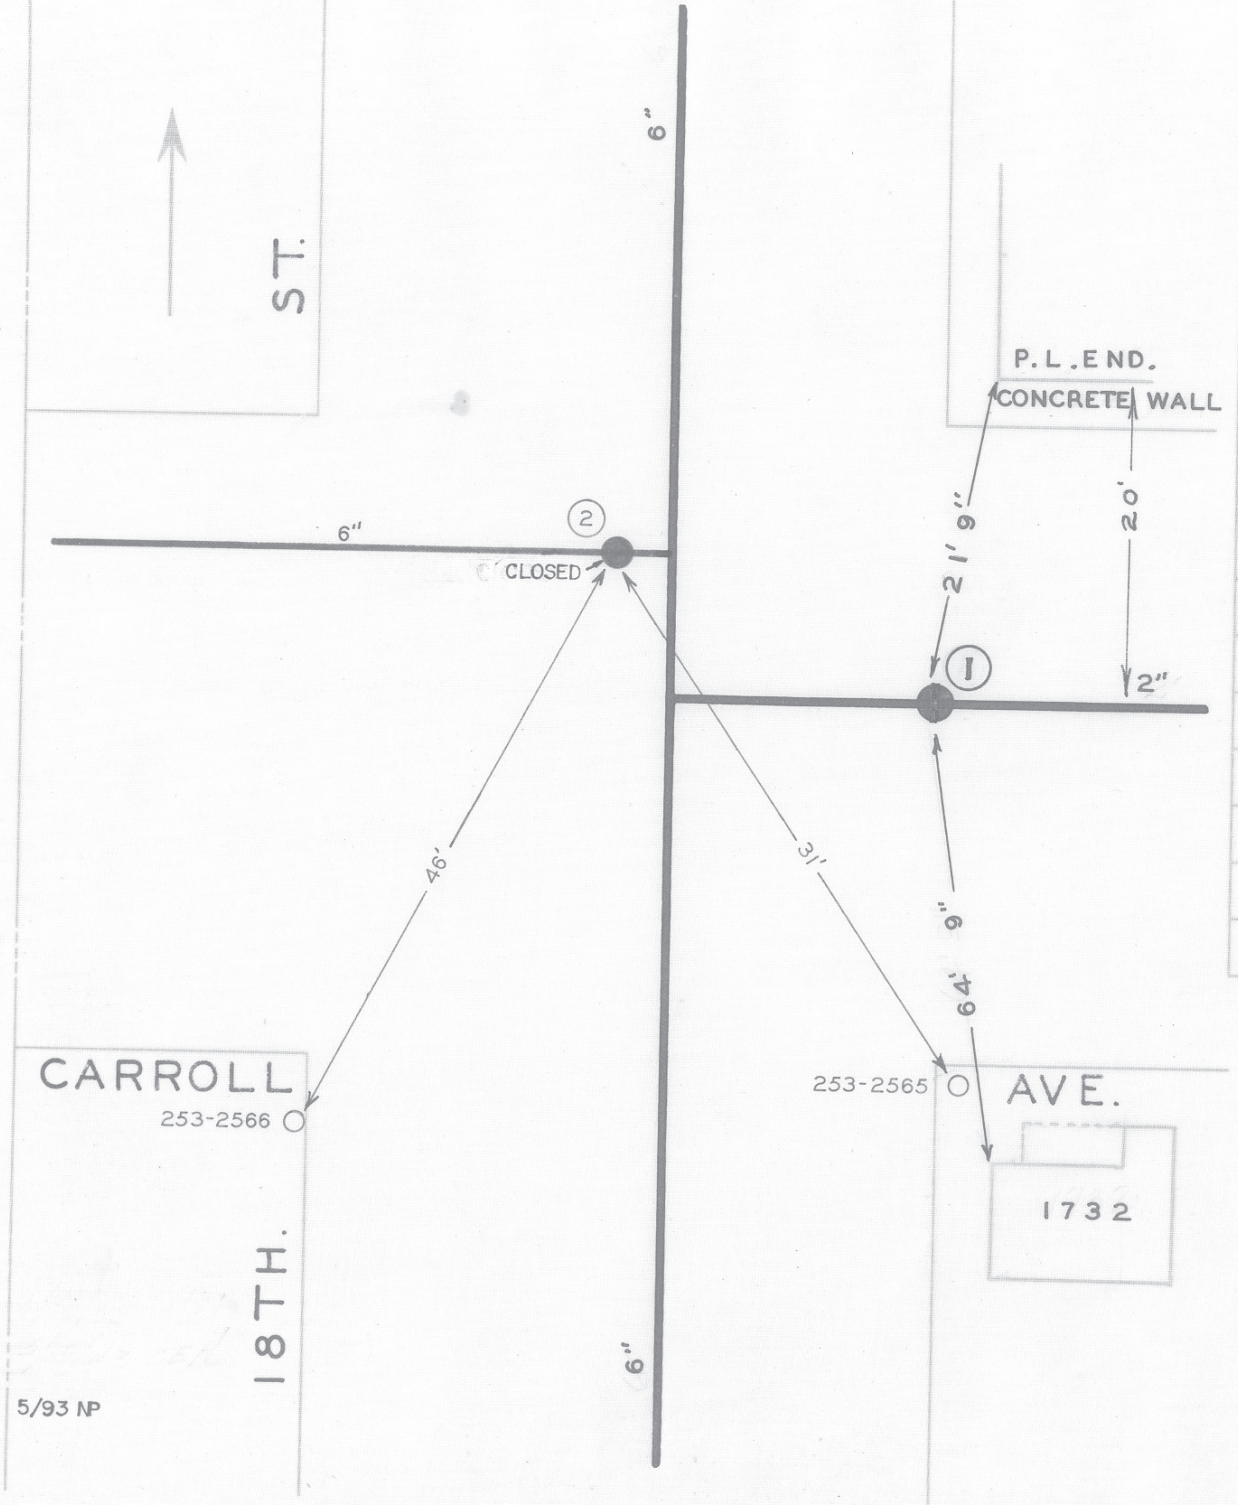

DATE	NO.	SIZE	MAKE	OPEN	TURNS
1935	1	2"		L	6 1/2
72	2	6"	MUELLER	R	
	1	10'-W	EPL		

CITY OF ROANOKE—WATER DEP'T

VALVE DIAGRAM

CARROLL AVE. & 18TH. ST. N.W.

SEC. MAP 233

DATE

PAGE NO. NW 229