DATE	NO.	SIZE	MAKE	OPEN	TURNS
1940	1	6"		R	20 1/2
2-62	2	6"	DARLING	R	
5-72	3	8"	MUELLER	R	
	1	0	SPL		
	2	0	EPL		

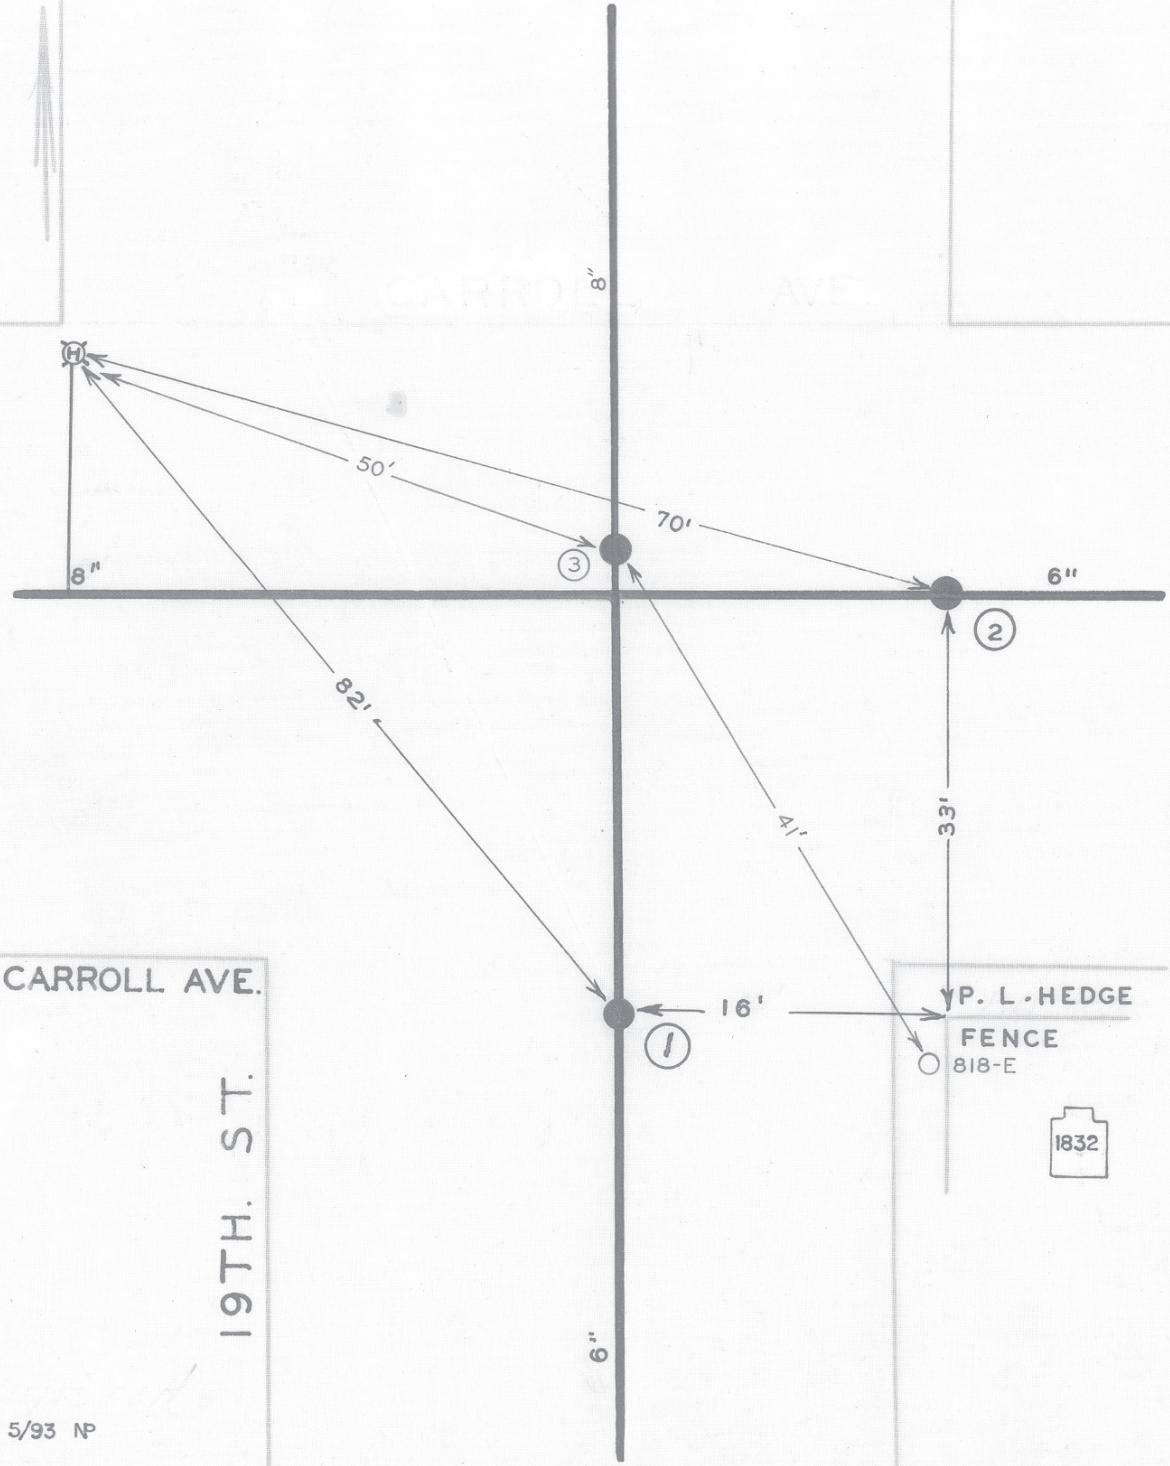

5/93 NP

CITY OF ROANOKE—WATER DEP'T

VALVE DIAGRAM

CARROLL AVE. & 19TH. ST. N. W.

SEC. MAP 233

DATE

PAGE NO. NW 230