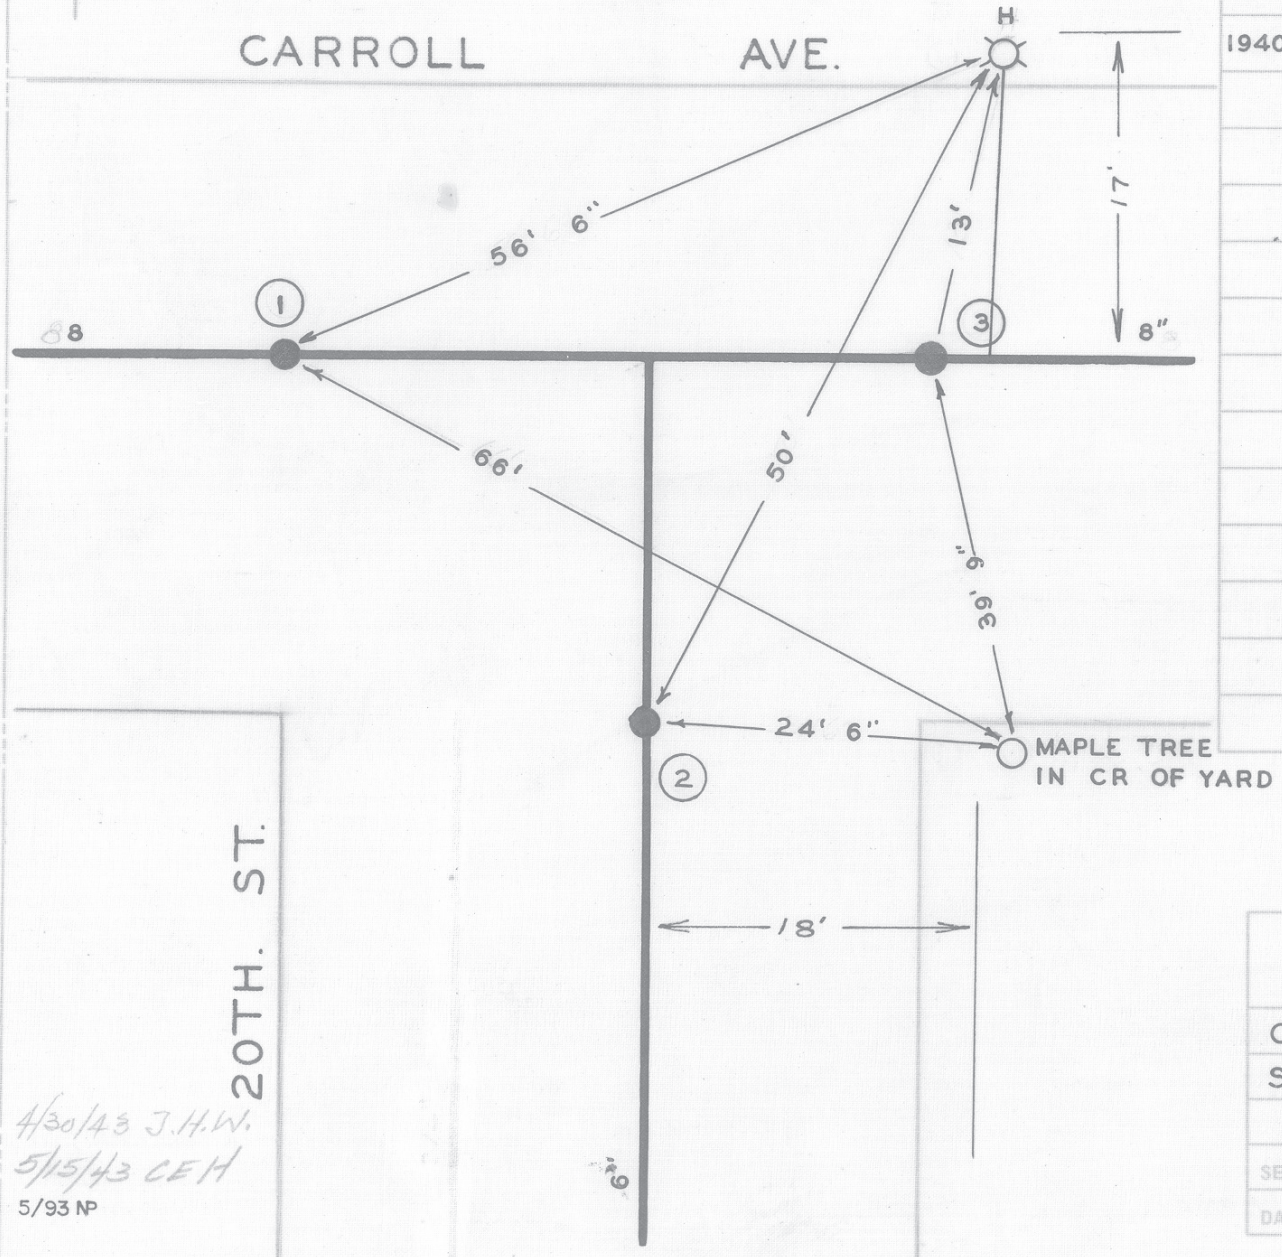

DATE	NO.	SIZE	MAKE	OPEN	TURNS
1940	1	8"		R	27
1940	2	6"		R	20 1/2
1940	3	8"		R	27
	1	8'-E	WPL		
	2	0	SPL		
	3	0	EPL		

4/30/43 J.H.W.
5/15/43 CEH
5/93 NP

CITY OF ROANOKE—WATER DEP'T
VALVE DIAGRAM
CARROLL AVE. & 20TH. ST. N. W.

SEC. MAP 233
DATE
PAGE NO. NW 231