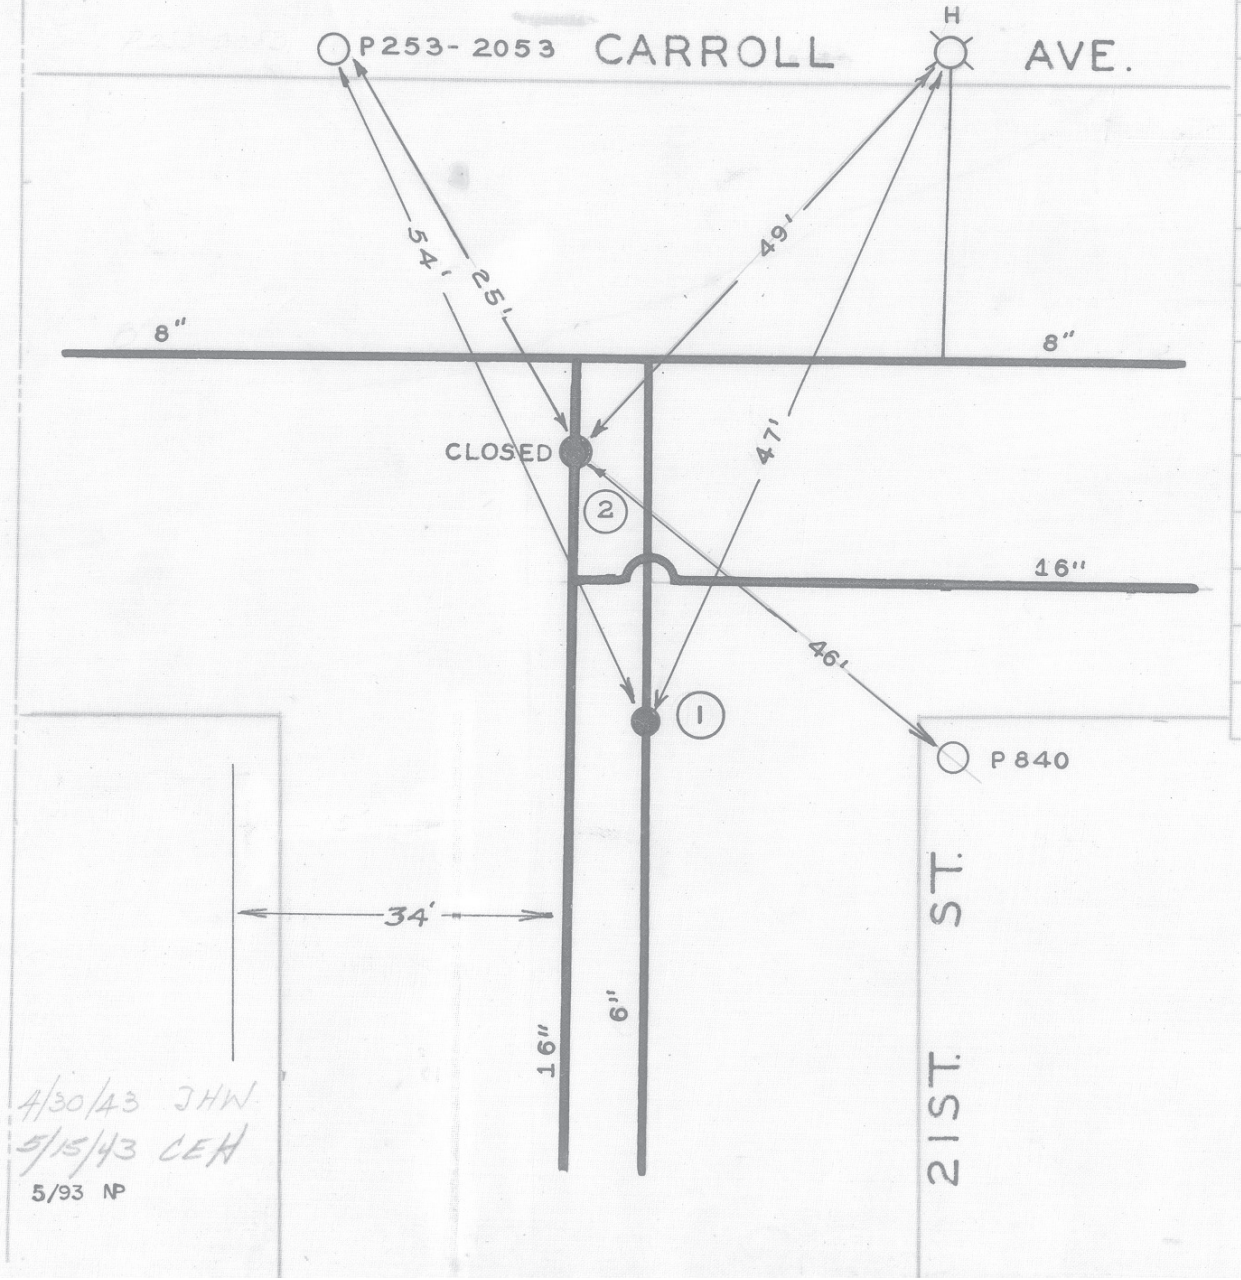

DATE	NO.	SIZE	MAKE	OPEN	TURNS
1940	1	6"		R	21
1946	2	8"	M. & H.	L	18
	1	0	SPL		
	2	26'-N	SPL		

4/30/43 JHW
5/15/43 CEH
5/93 NP

CITY OF ROANOKE—WATER DEP'T
VALVE DIAGRAM
CARROLL AVE. & 21ST. ST. N.W.

SEC. MAP 233
DATE
PAGE NO. NW 232