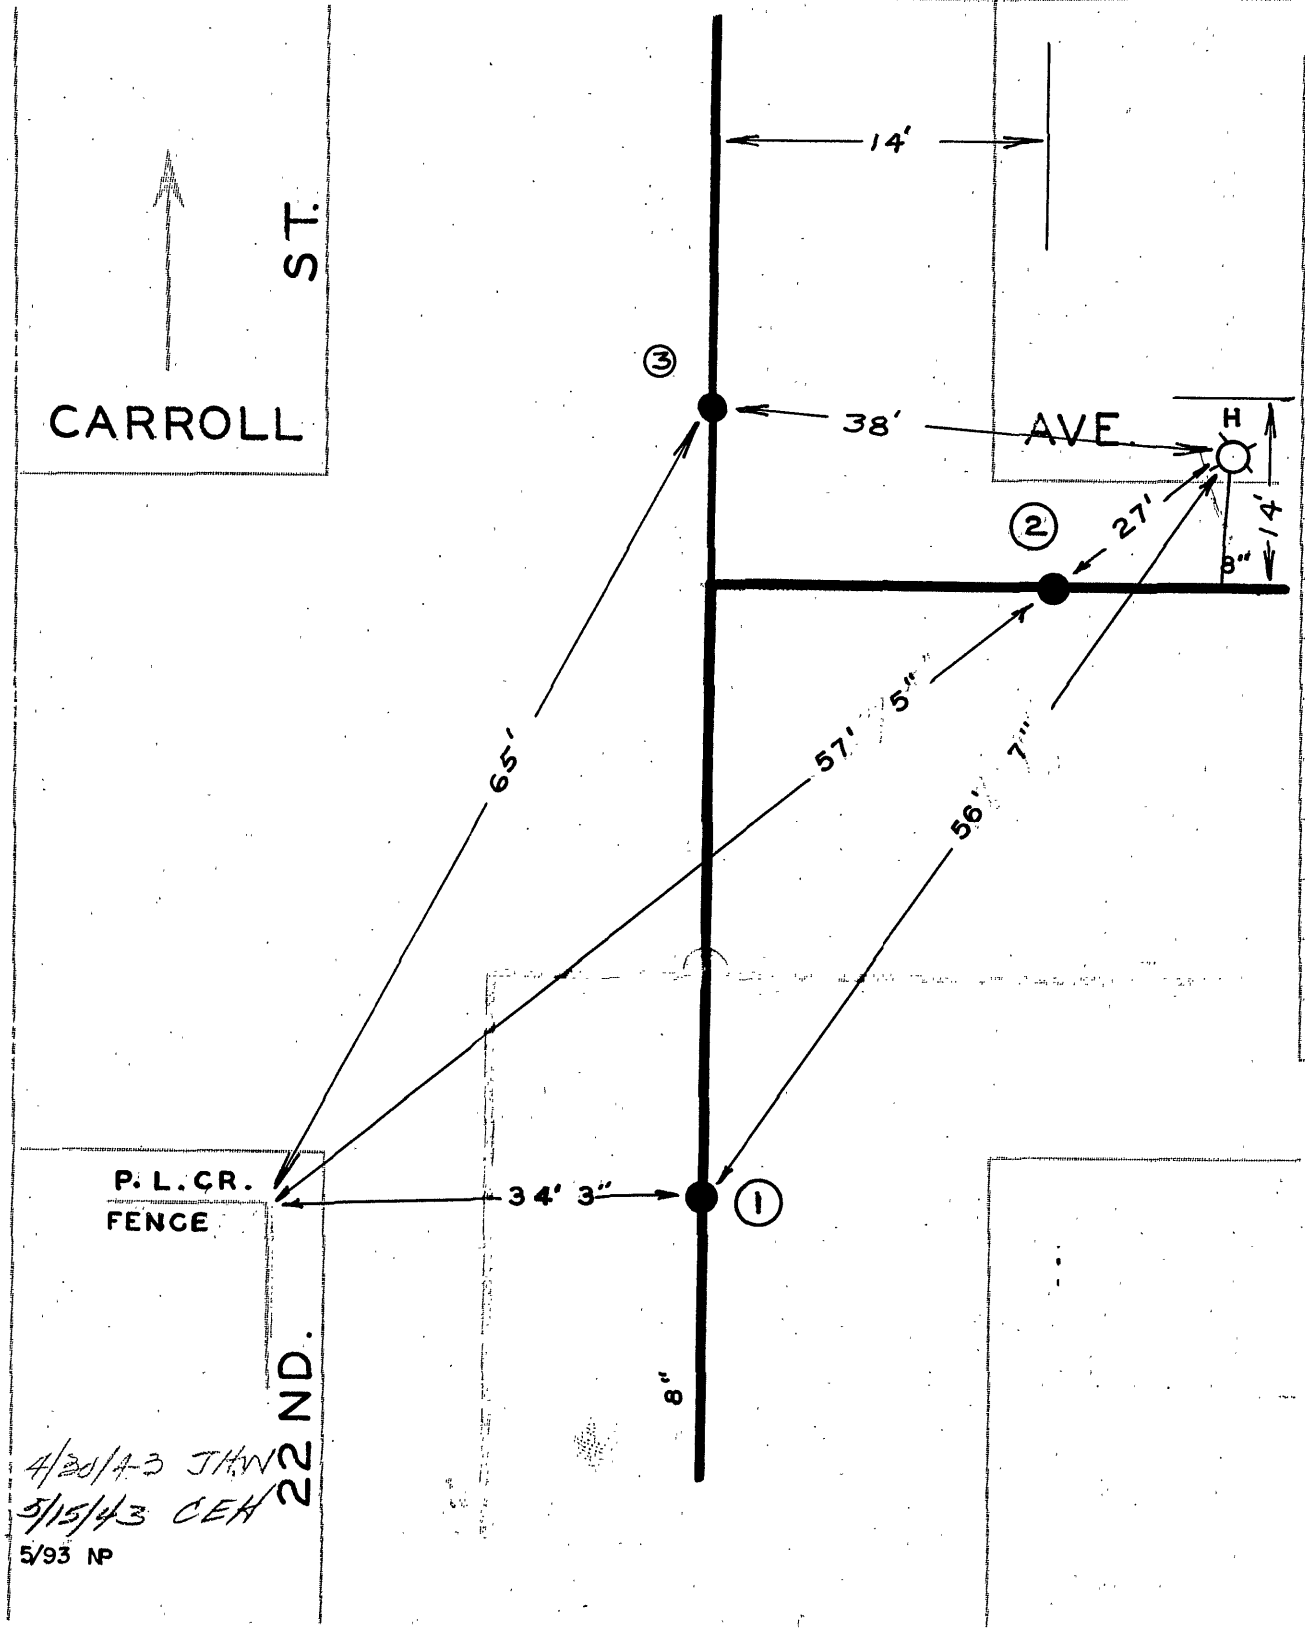

DATE	NO.	SIZE	MAKE	OPEN	TURNS
1940	1	8"		R	26
1939	2	8"		R	27
1940	3	8"			
	1	0	SPL		
	2	0	EPL		
	3	3'-N	NPL		

4/20/43 JHW
5/15/43 CEK
5/93 NP

CITY OF ROANOKE—WATER DEP'T
VALVE DIAGRAM
CARROLL AVE. & 22ND. ST. N. W.

SEC. MAP 233
DATE PAGE NO. NW 233