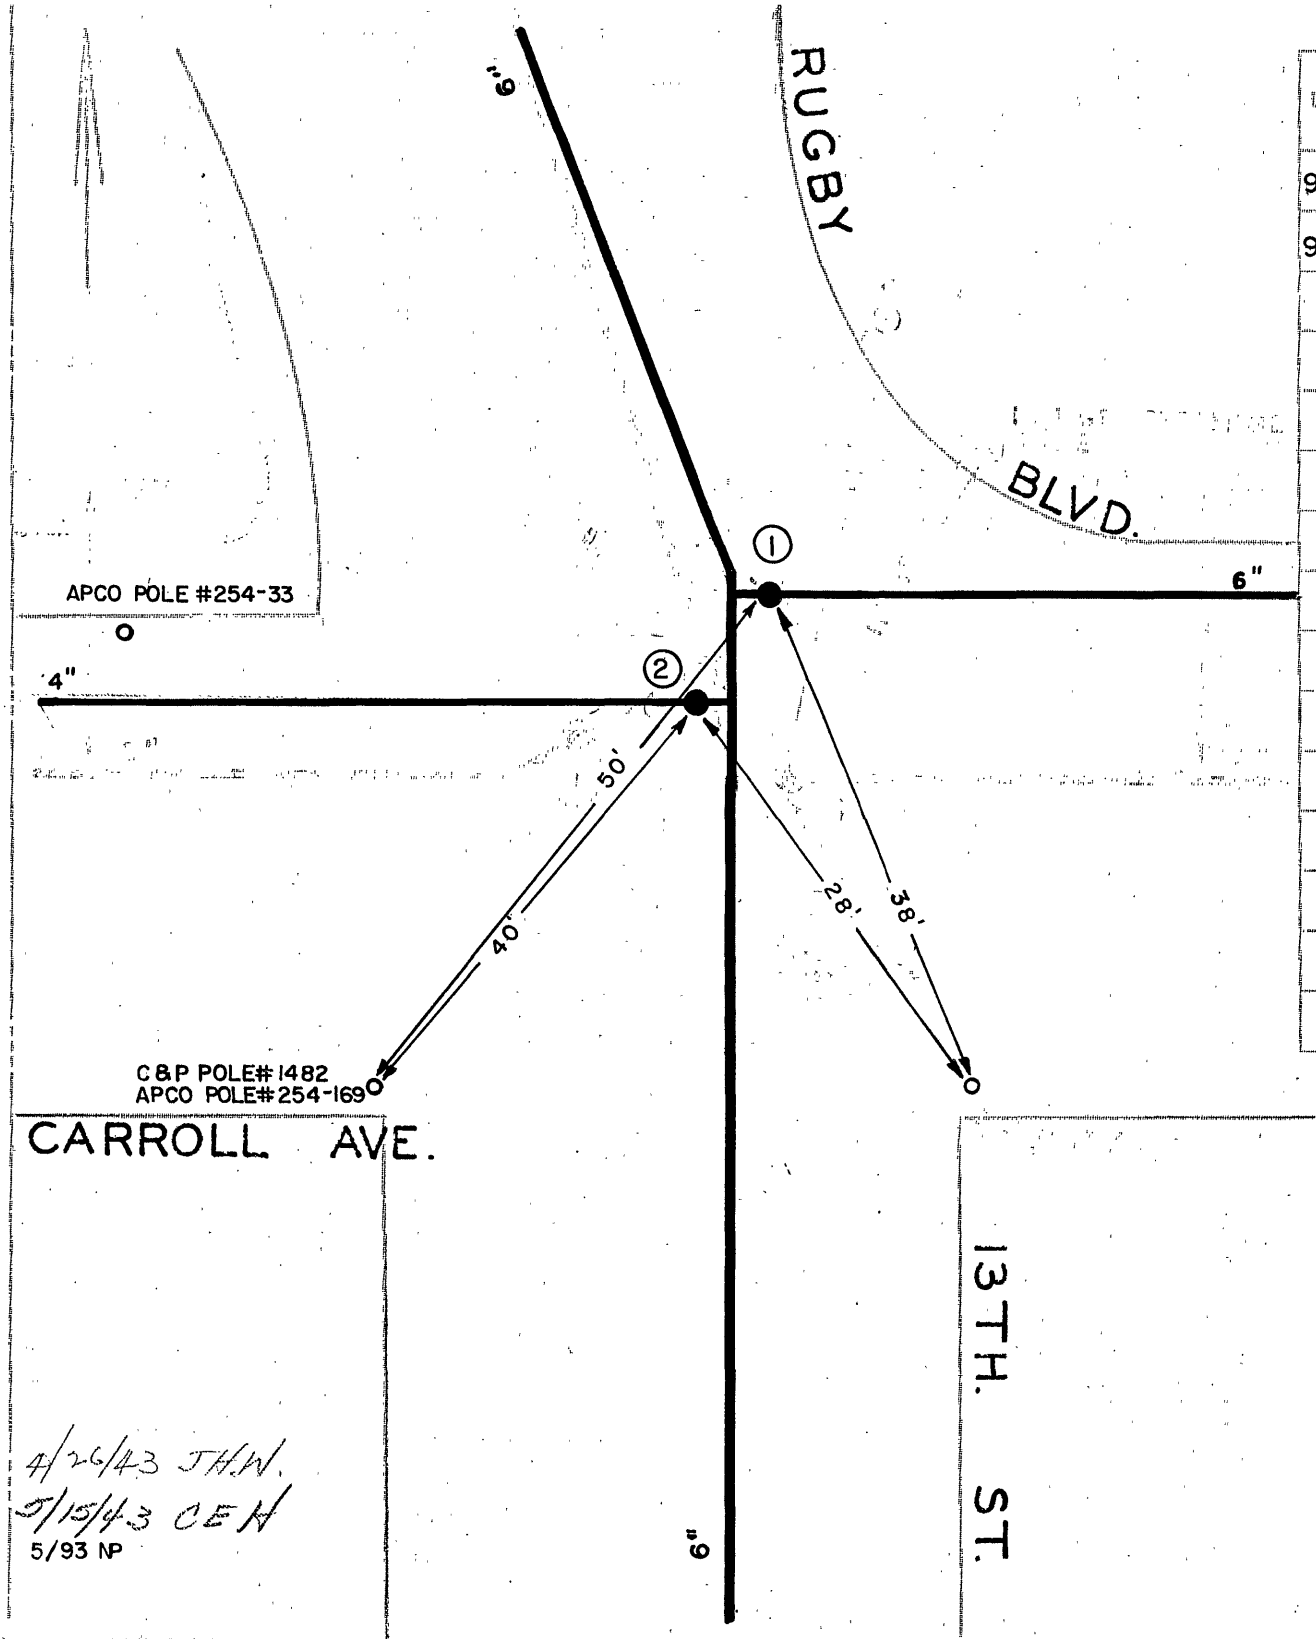

DATE	NO.	SIZE	MAKE	OPEN	TURNS
9-92	1	6"	MUELLER	R	19
9-92	2	4"	MUELLER	R	15

4/26/43 JHW.
5/15/43 CEH
5/93 NP

CITY OF ROANOKE—WATER DEPT
VALVE DIAGRAM
CARROLL AVE. & 13TH.
& RUGBY BLVD. N.W.

SEC. MAP 223

DATE PAGE NO. N.W.172