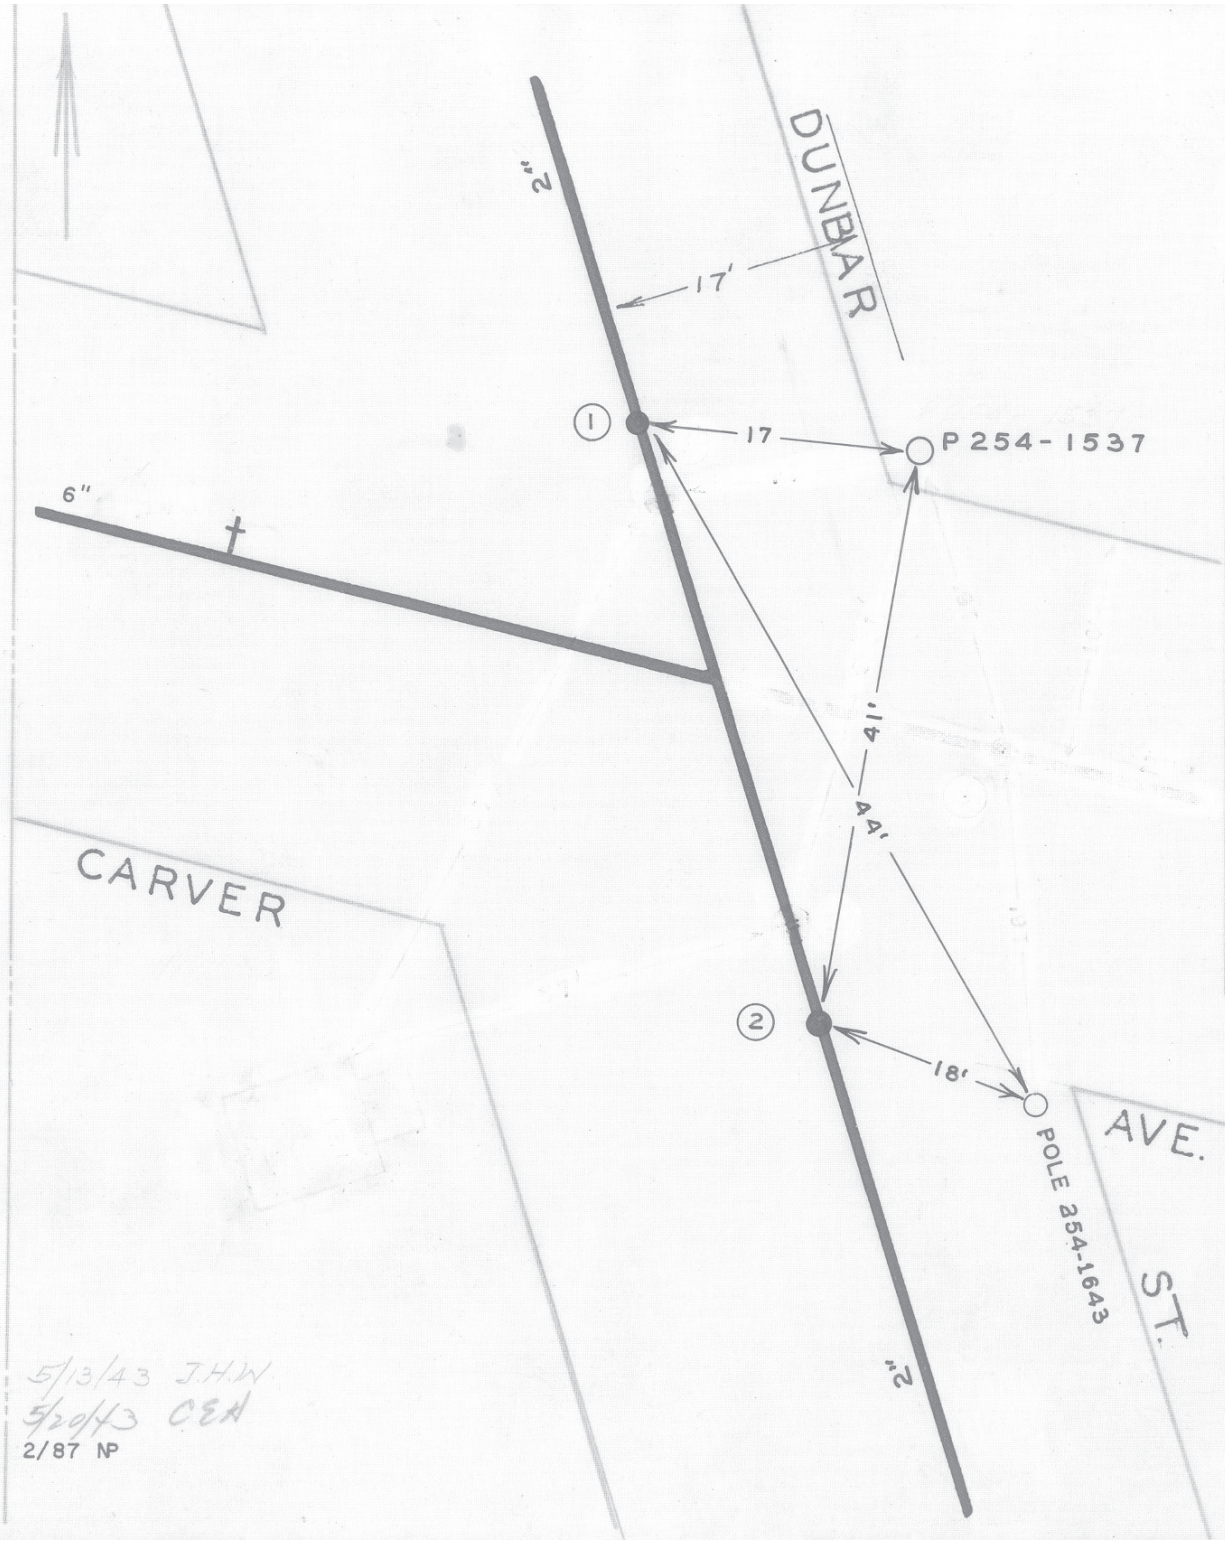

DATE	NO.	SIZE	MAKE	OPEN	TURNS
1-65	1	2"		R	
1-65	2	2"		R	
	1	0	NPL		
	2	0	SPL		

CITY OF ROANOKE—WATER DEP'T

VALVE DIAGRAM

CARVER ST. & DUNBAR ST. N. W.

SEC. MAP 204

DATE

PAGE NO. N.W.52

5/13/43 J.H.W.
5/20/43 CEA
2/87 NP