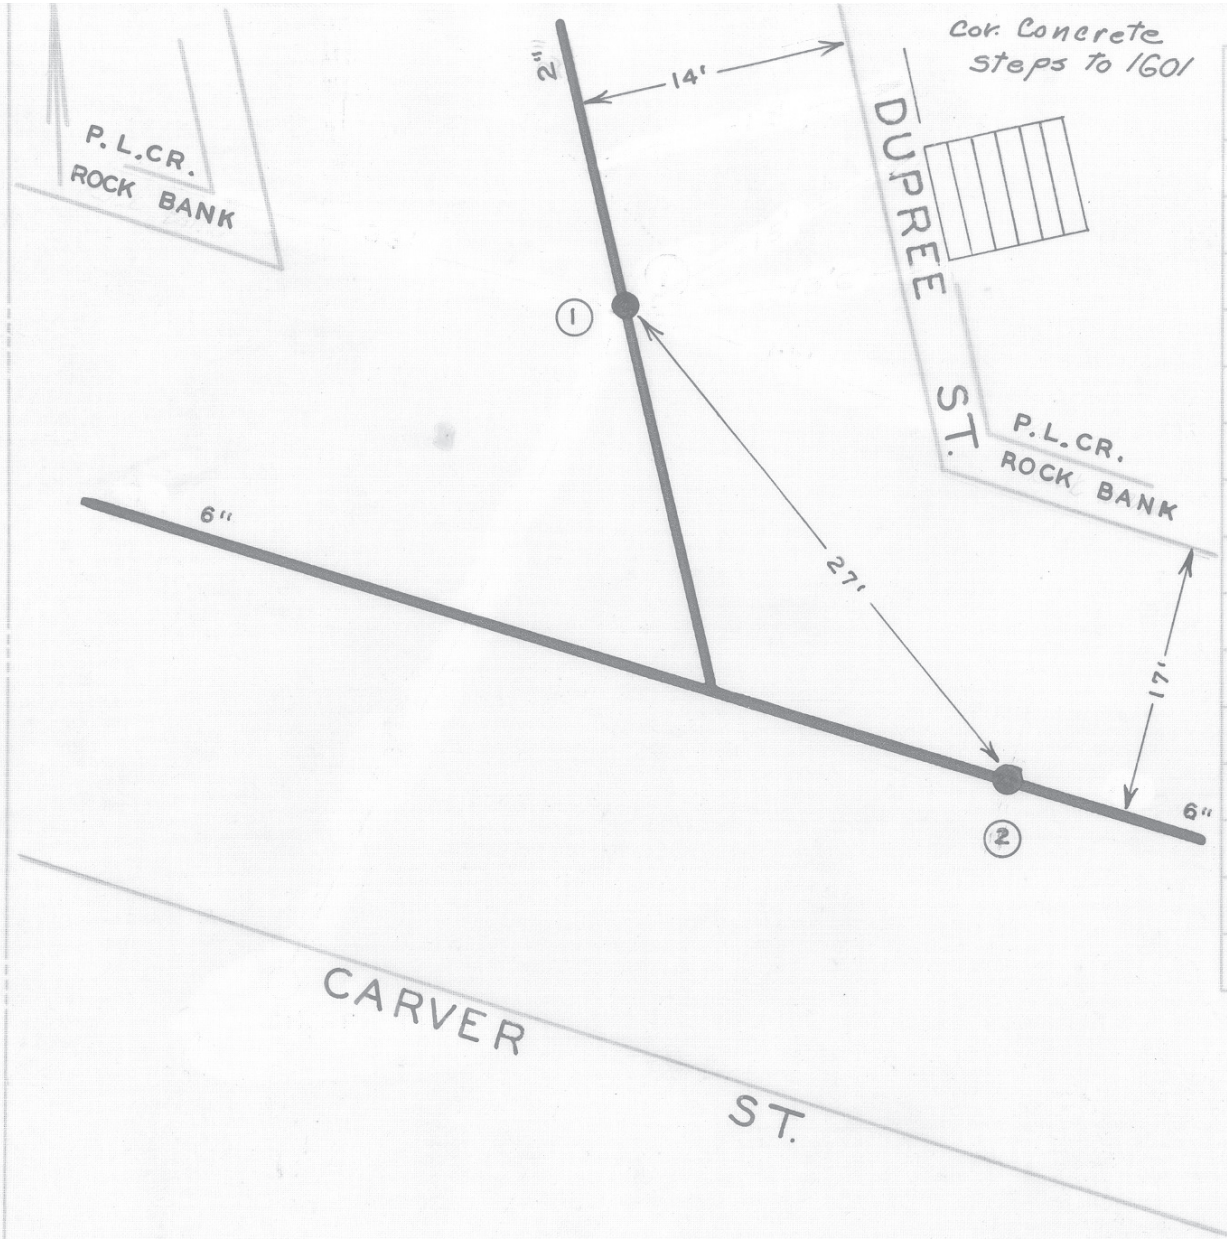

DATE	NO.	SIZE	MAKE	OPEN	TURNS
1-65	1	2"	DARLING	R	
1-65	2	6"	MUELLER	R	
	1	0	NPL		
	2	0	E.P.L.		

CITY OF ROANOKE—WATER DEP'T

VALVE DIAGRAM

CARVER STREET &

DUPREE STREET N.W.

SEC. MAP 204

DATE

PAGE NO. N.W.50

5/13/43 J.HW
5/20/43 CEH

2/87 NP