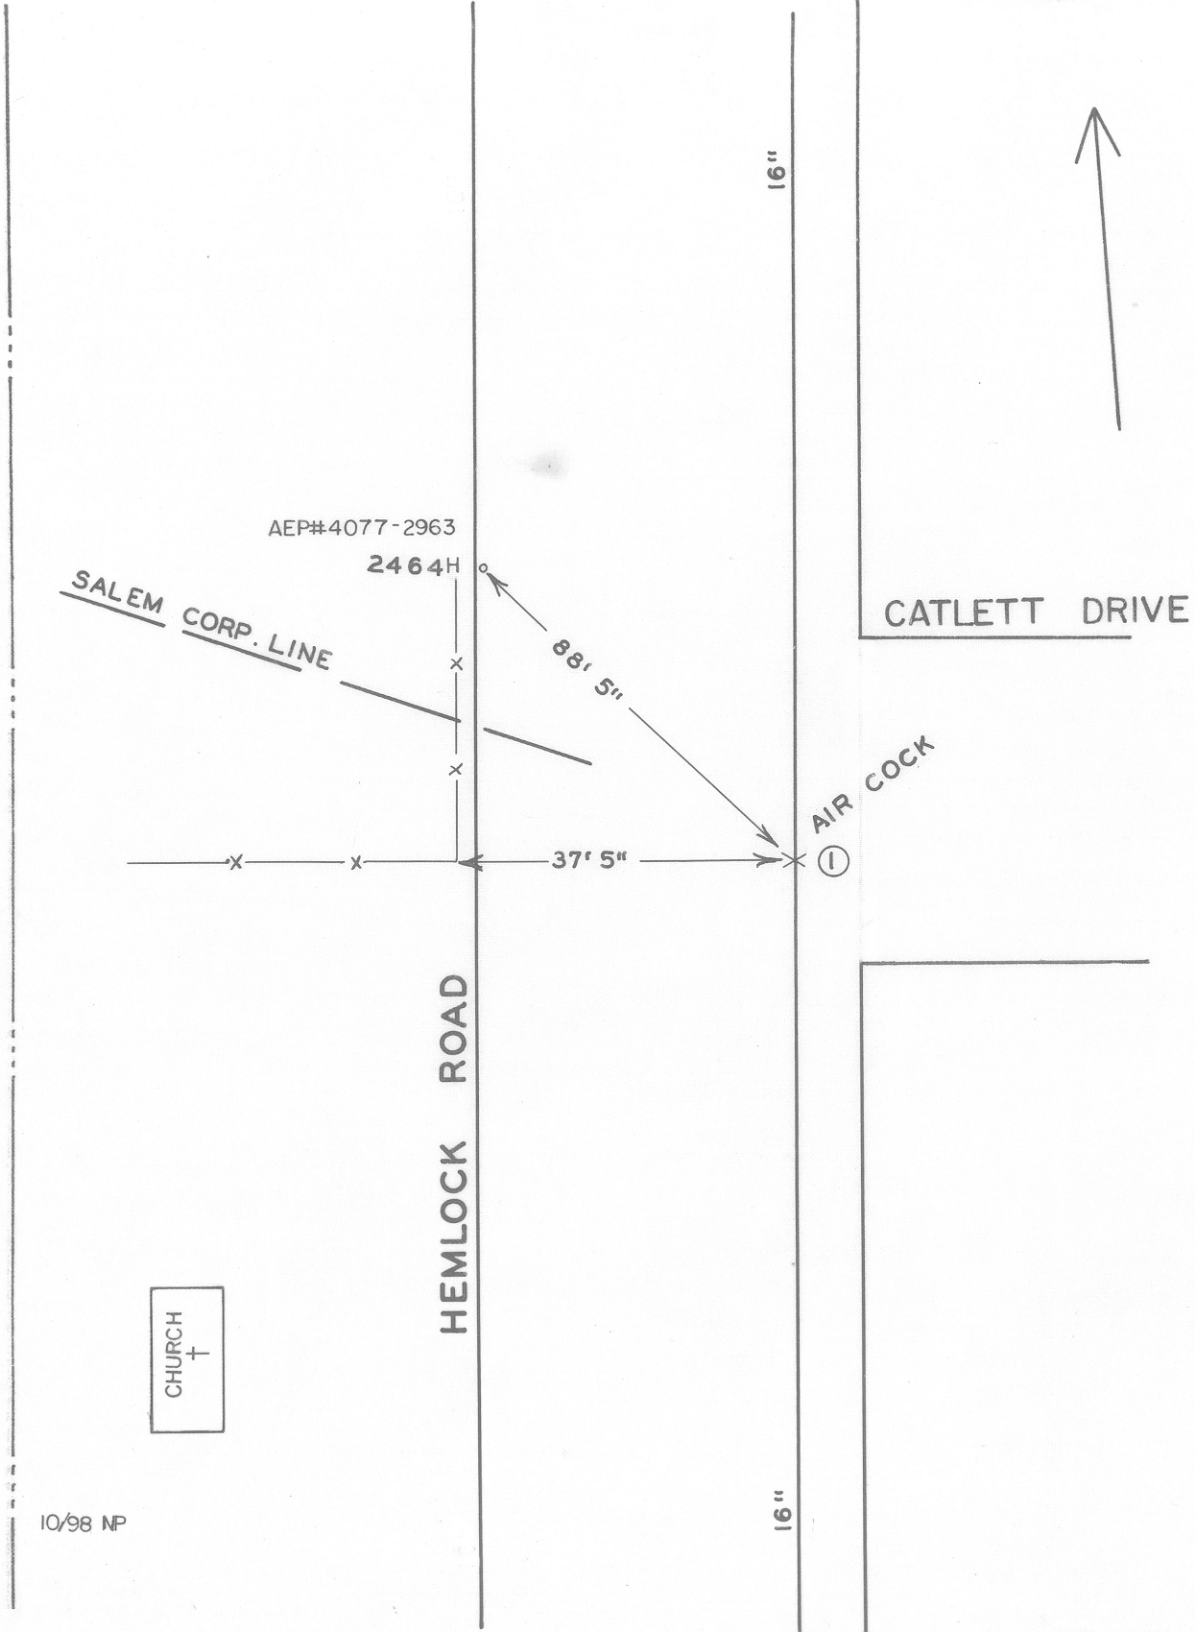

DATE	NO.	SIZE	MAKE	OPEN	TURNS
6-63	1	1"	AIR COCK		

CITY OF ROANOKE—WATER DEPT.

VALVE DIAGRAM

CATLETT DRIVE

HEMLOCK ROAD AT

SALEM CORP. LINE

SEC. MAP ~~50~~ 604 N.W.

DATE PAGE NO.