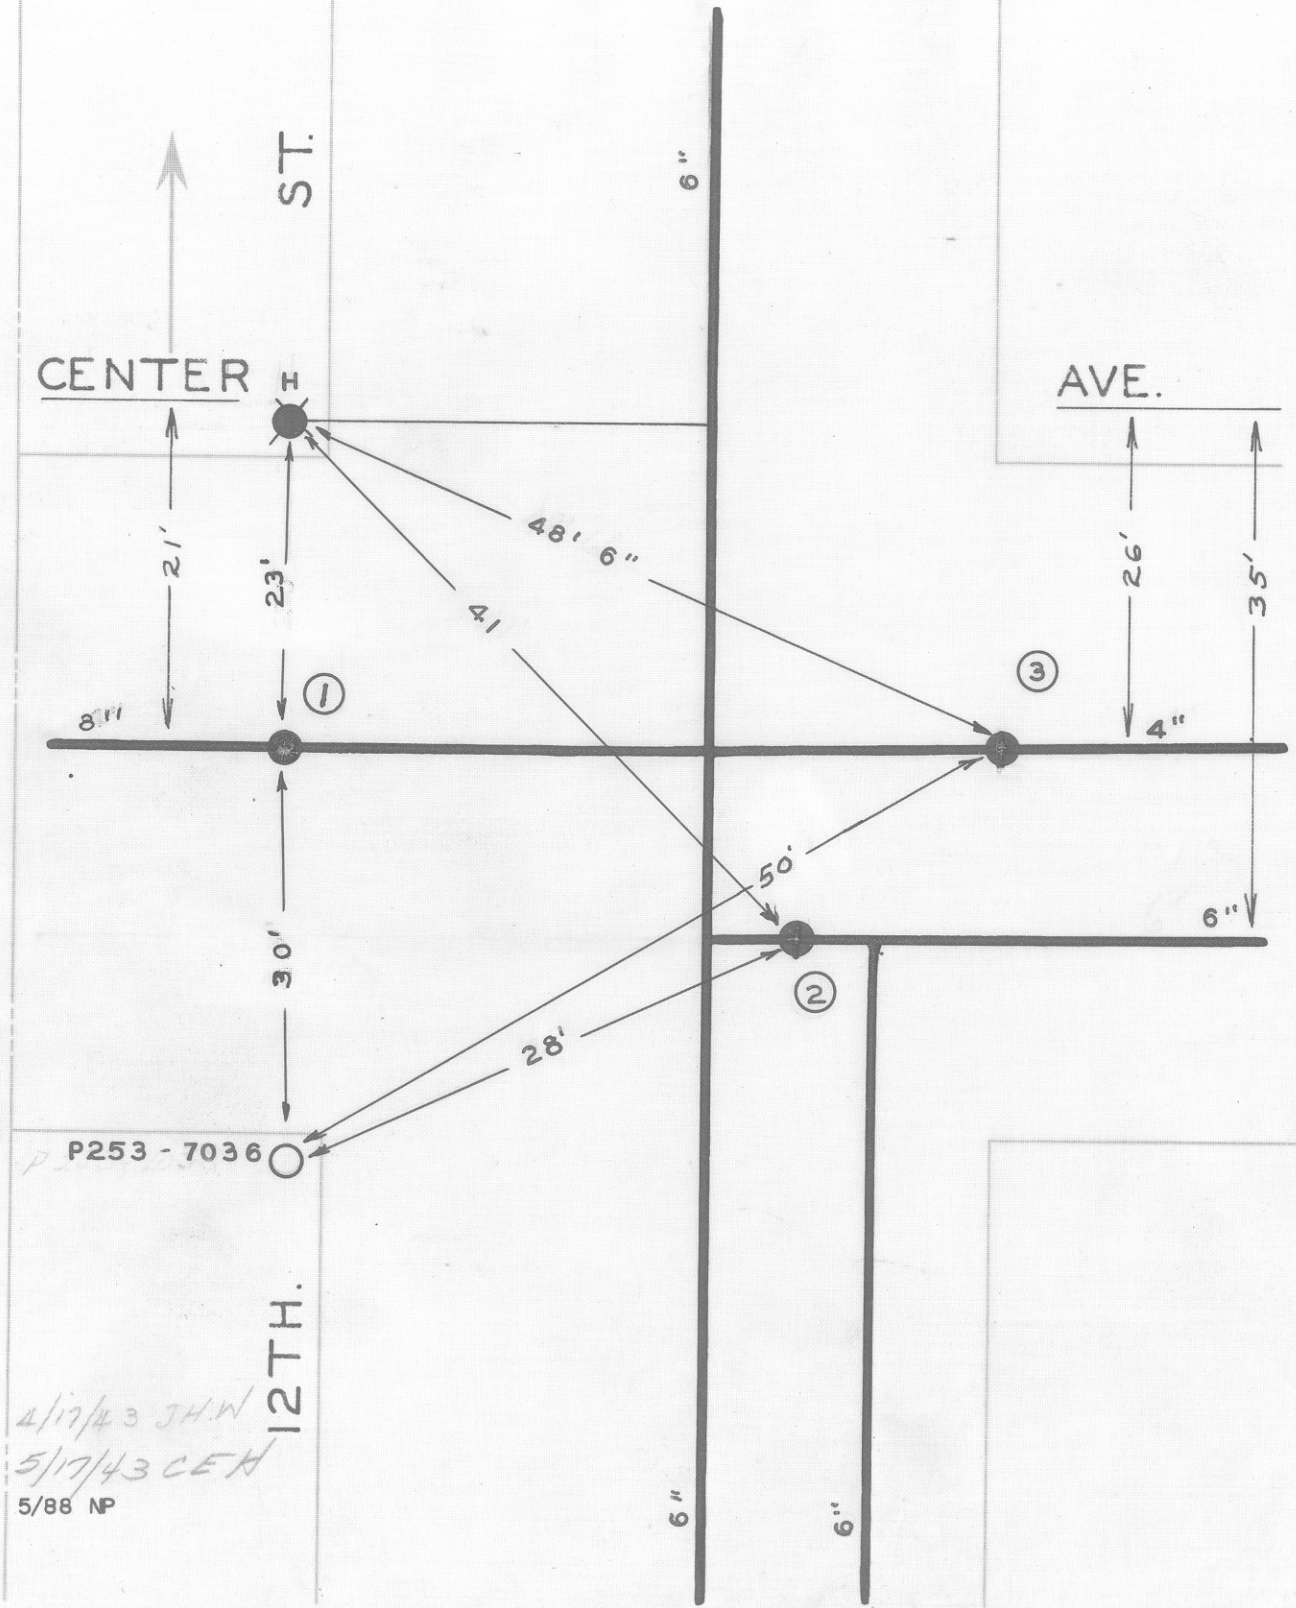

DATE	NO.	SIZE	MAKE	OPEN	TURNS
1948	1	8"	DARLING	R	27
1923	2	6"		R	21
1890	3	6"		R	21
	1	2'-E	WPL		
	2	21'-W	EPL		
	3	2'-W	EPL		

4/17/43 JHW
5/17/43 CEH
5/88 NP

CITY OF ROANOKE—WATER DEP'T
VALVE DIAGRAM
CENTER AVE. & 12TH. ST. N.W.

SEC. MAP 221
DATE
PAGE NO. NW.117