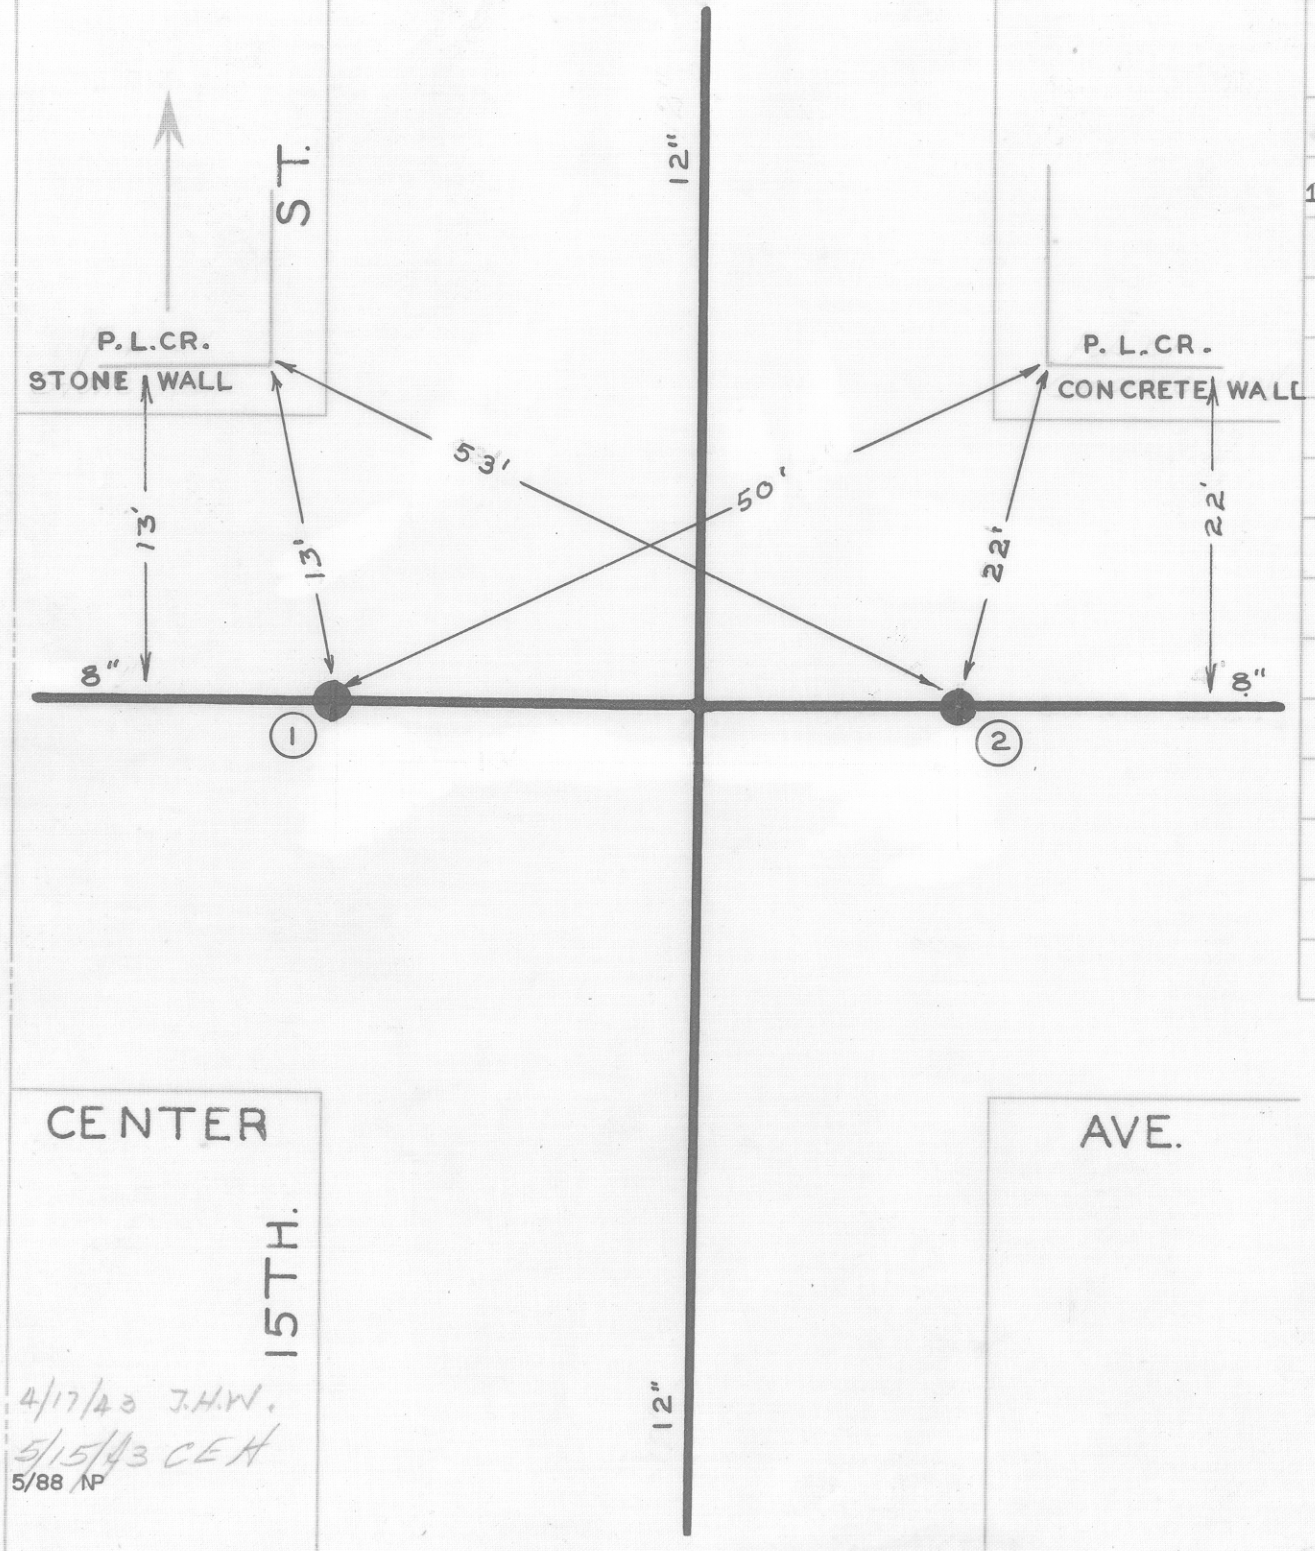

DATE	NO.	SIZE	MAKE	OPEN	TURNS
1890	1	8"		R	27
1948	2	8"	DARLING	R	27
	1	2'-E	WPL		
	2	3'-W	EPL		

4/17/43 J.H.W.
5/15/43 CEH
5/88 NP

CITY OF ROANOKE—WATER DEP'T
VALVE DIAGRAM

CENTER AVE. & 15TH. ST. N.W.

SEC. MAP 221

DATE PAGE NO. N.W. 119