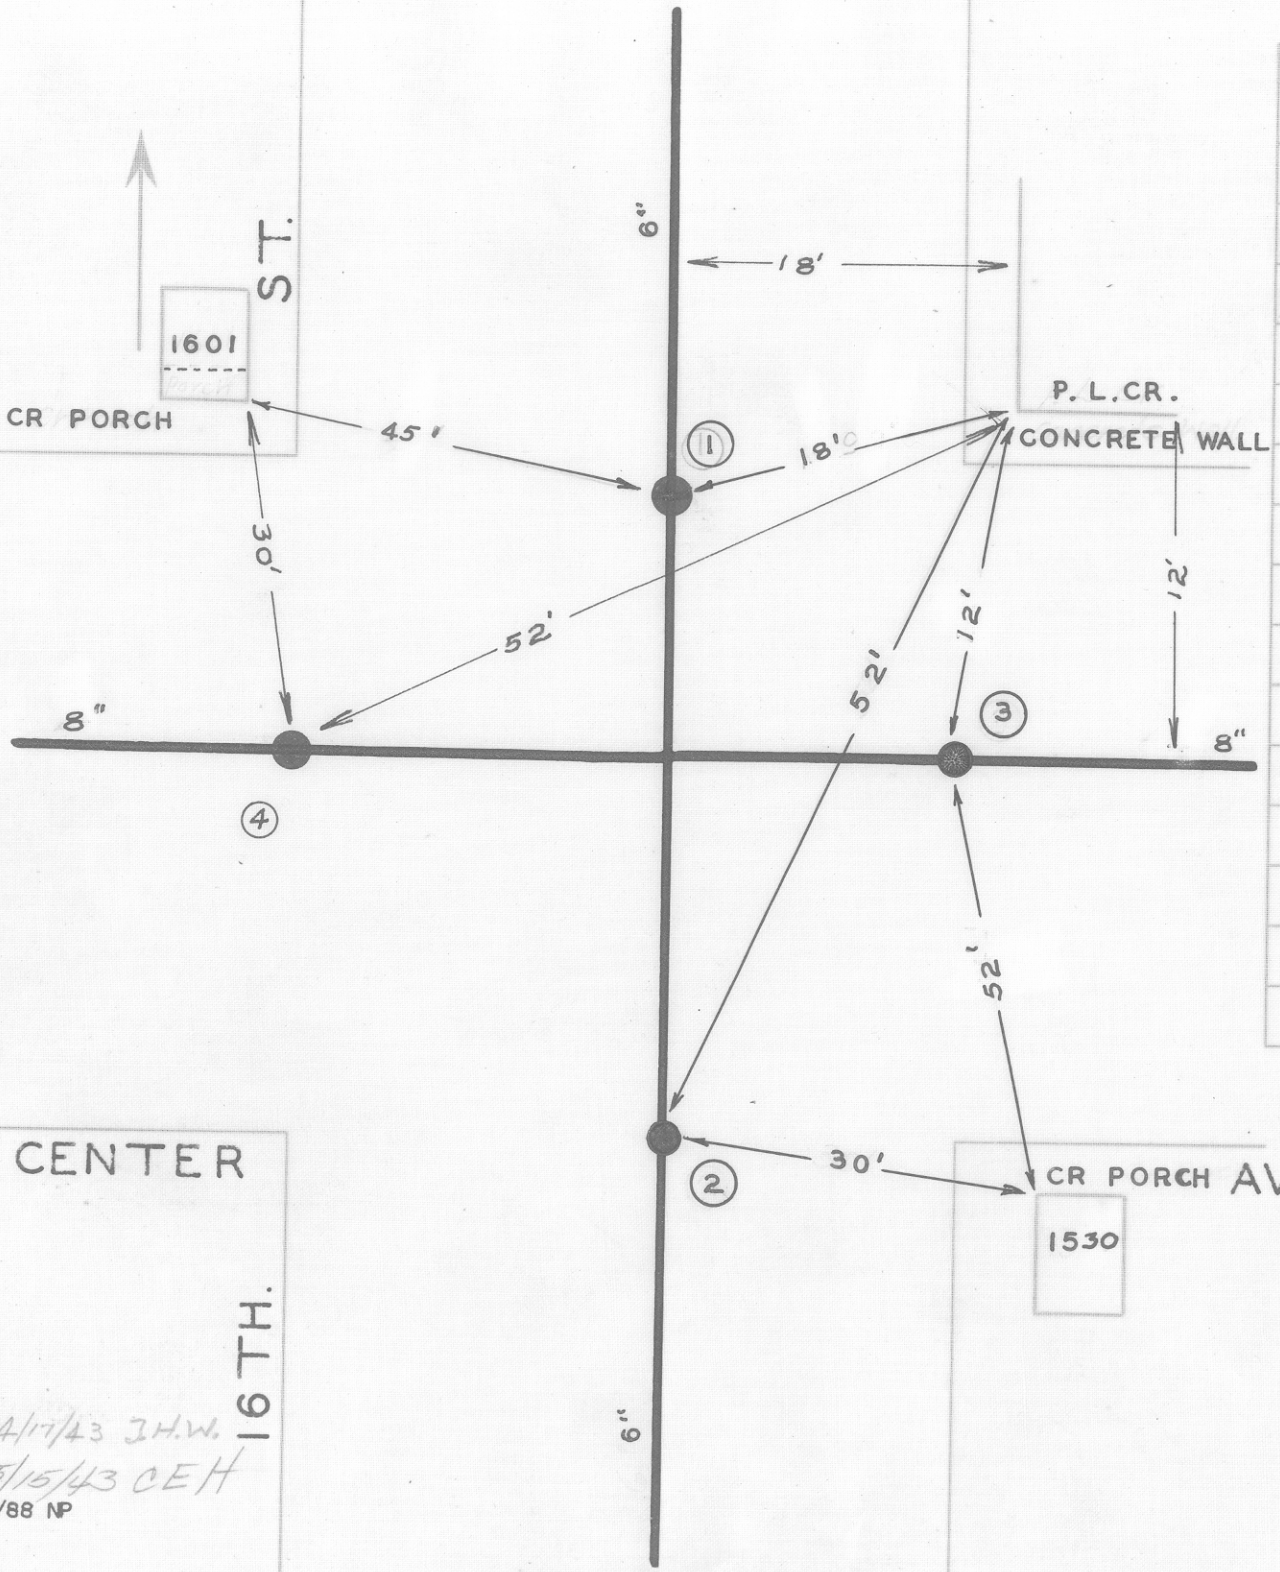

DATE	NO.	SIZE	MAKE	OPEN	TURNS
1905	1	6"		R	20 1/2
1939	2	6"		R	21
1890	3	8"		R	
1950	4	8"		R	
	1	0	NPL		
	2	0	SPL		
	3	3'-W	EPL		
	4	0	WPL		

4/17/43 J.H.W.
5/15/43 CEH
5/88 NP

CITY OF ROANOKE—WATER DEP'T
VALVE DIAGRAM
CENTER AVE. & 16TH.
ST. N. W.

SEC. MAP 221
DATE
PAGE NO. N.W. 120