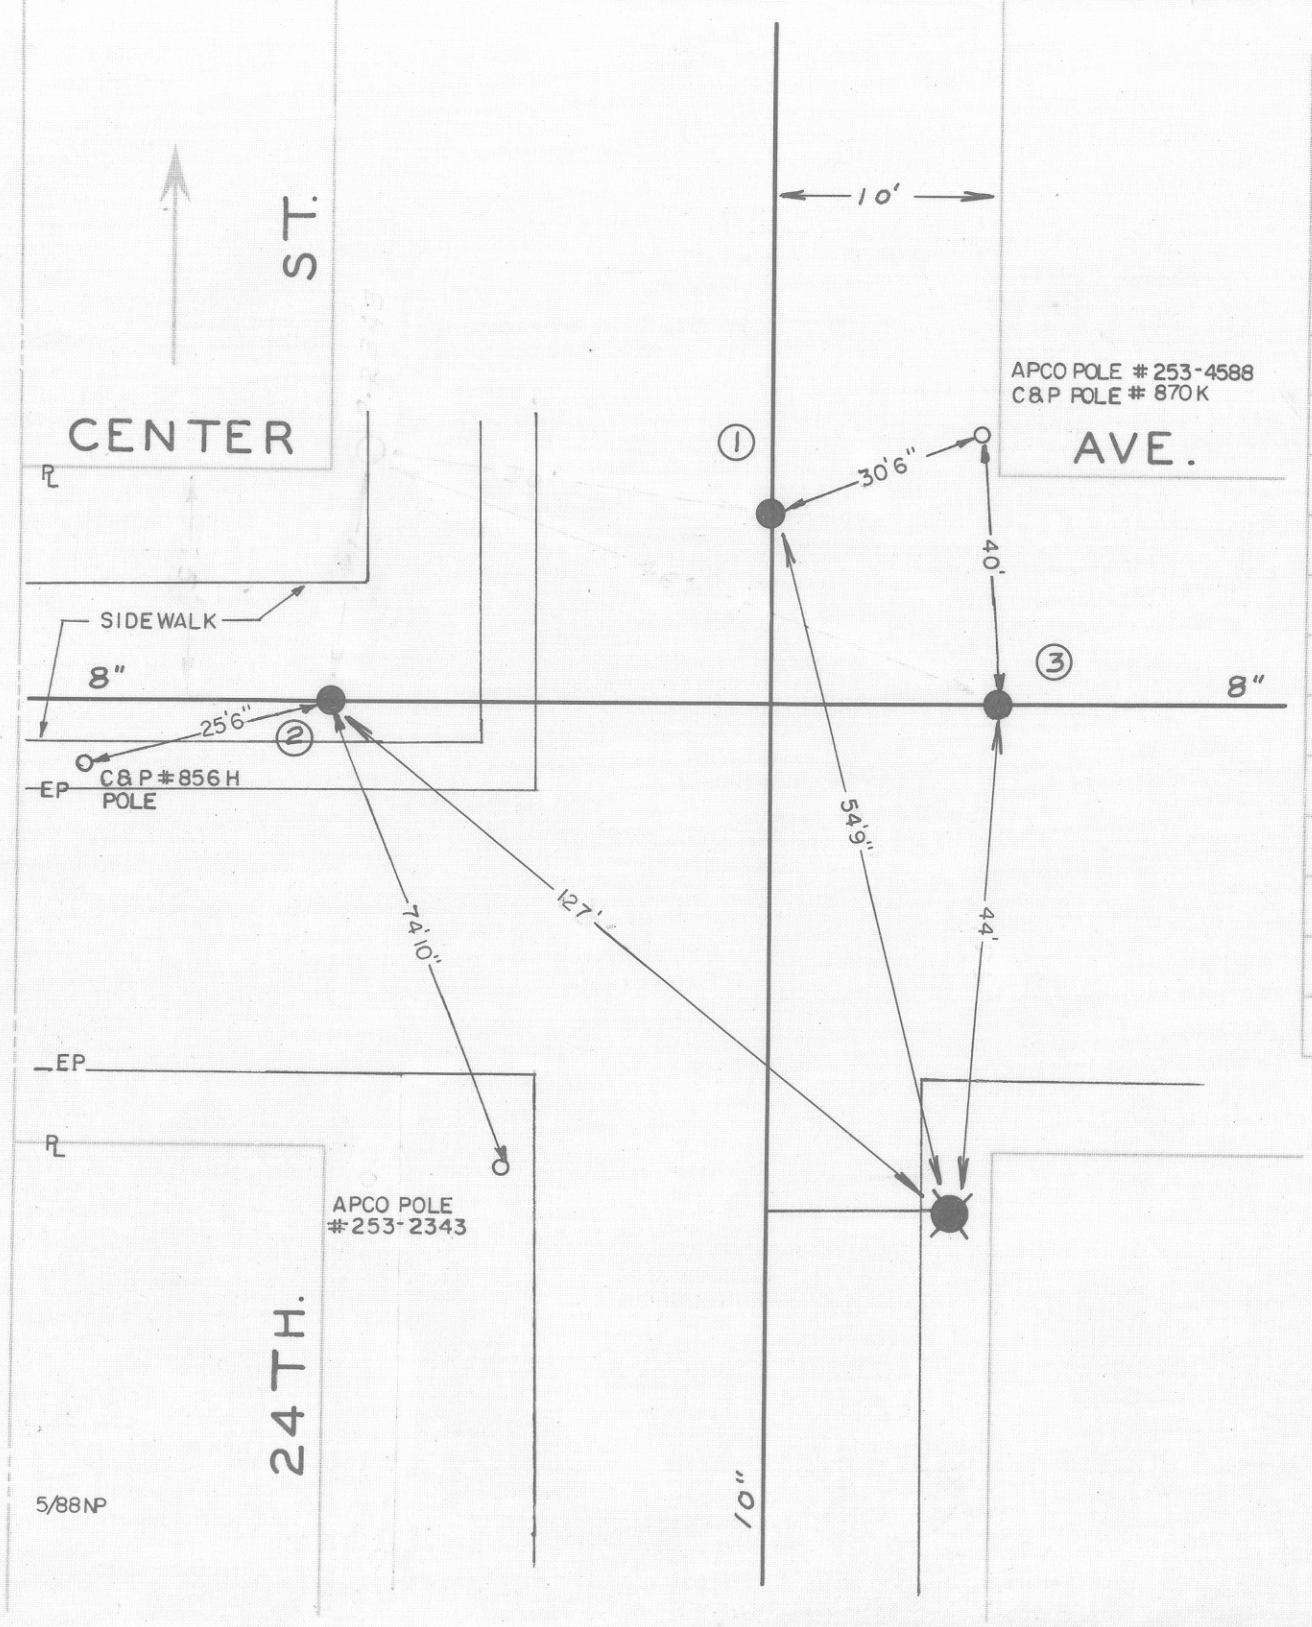

DATE	NO.	SIZE	MAKE	OPEN	TURNS
1937	1	10"			
1952	2	8"	MUELLER	R	27
1950	3	8"	DARLING	R	27
	1	7'-S	NPL		
	2	0	WPL		
	3	0	EPL		

CITY OF ROANOKE—WATER DEP'T

VALVE DIAGRAM

CENTER AVE. & 24TH.

STREET N.W.

SEC. MAP 231, 242

DATE PAGE NO.