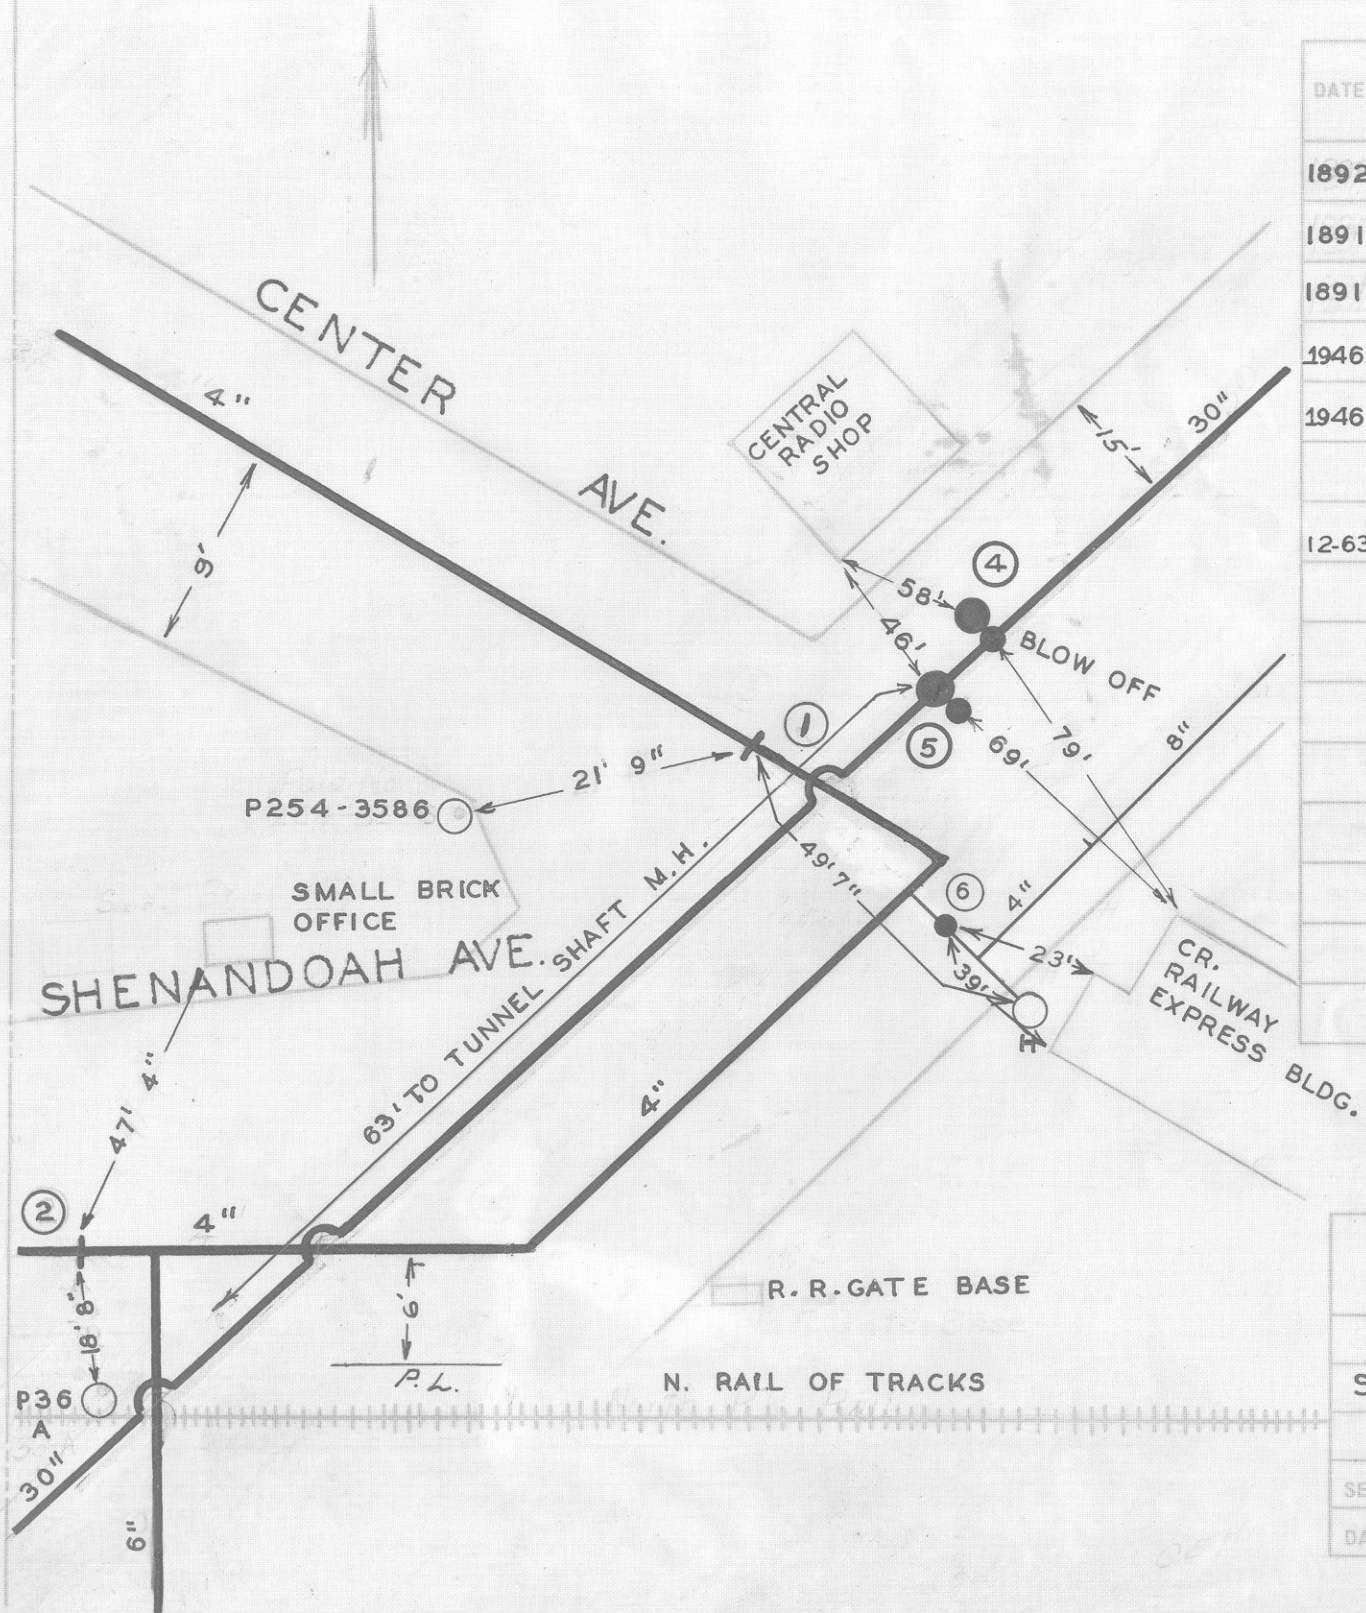

DATE	NO.	SIZE	MAKE	OPEN	TURNS
1892	1	4"		R	15
1891	2	4"		R	8
1891	3	ABANDONDED			
1946	4	8"	M. & H.	L	18
1946	5	24	M & H	L	105
		4"	BY PASS	L	9
12-63	6	4"		R	9½
	1	21'-E	WPL		
	2	132'-W	WPL		
	4	0	NPL	SHEN.	
	5	0	NPL	SHEN.	

CITY OF ROANOKE—WATER DEP'T

VALVE DIAGRAM

CENTER AVE. 2ND. ST. & SHENADOAH AVE. N.W

SEC. MAP 201

DATE

PAGE NO. N.W. 3