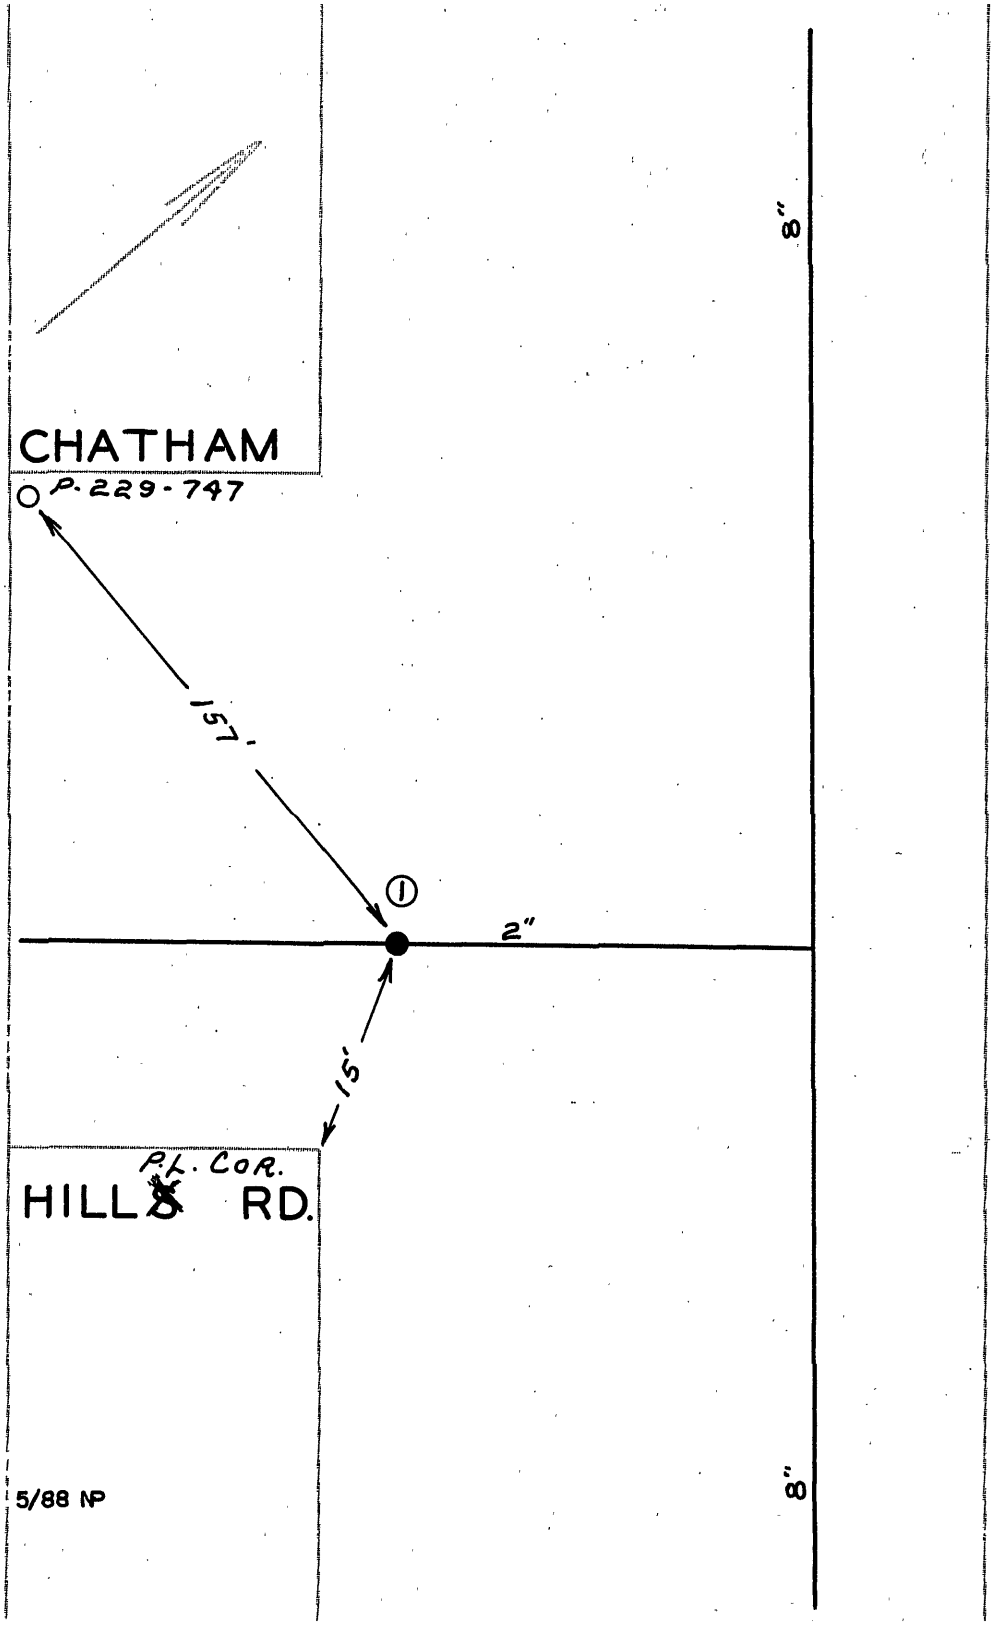

DATE	NO.	SIZE	MAKE	OPEN	TURNS
56	1	2"	DARLING	R	
	1	5'-N	SPL		

CITY OF ROANOKE—WATER DEP'T

VALVE DIAGRAM

CHATHAM HILL RD. &

FOREST PARK BLVD. N.W.

SEC. MAP 256

DATE PAGE NO.