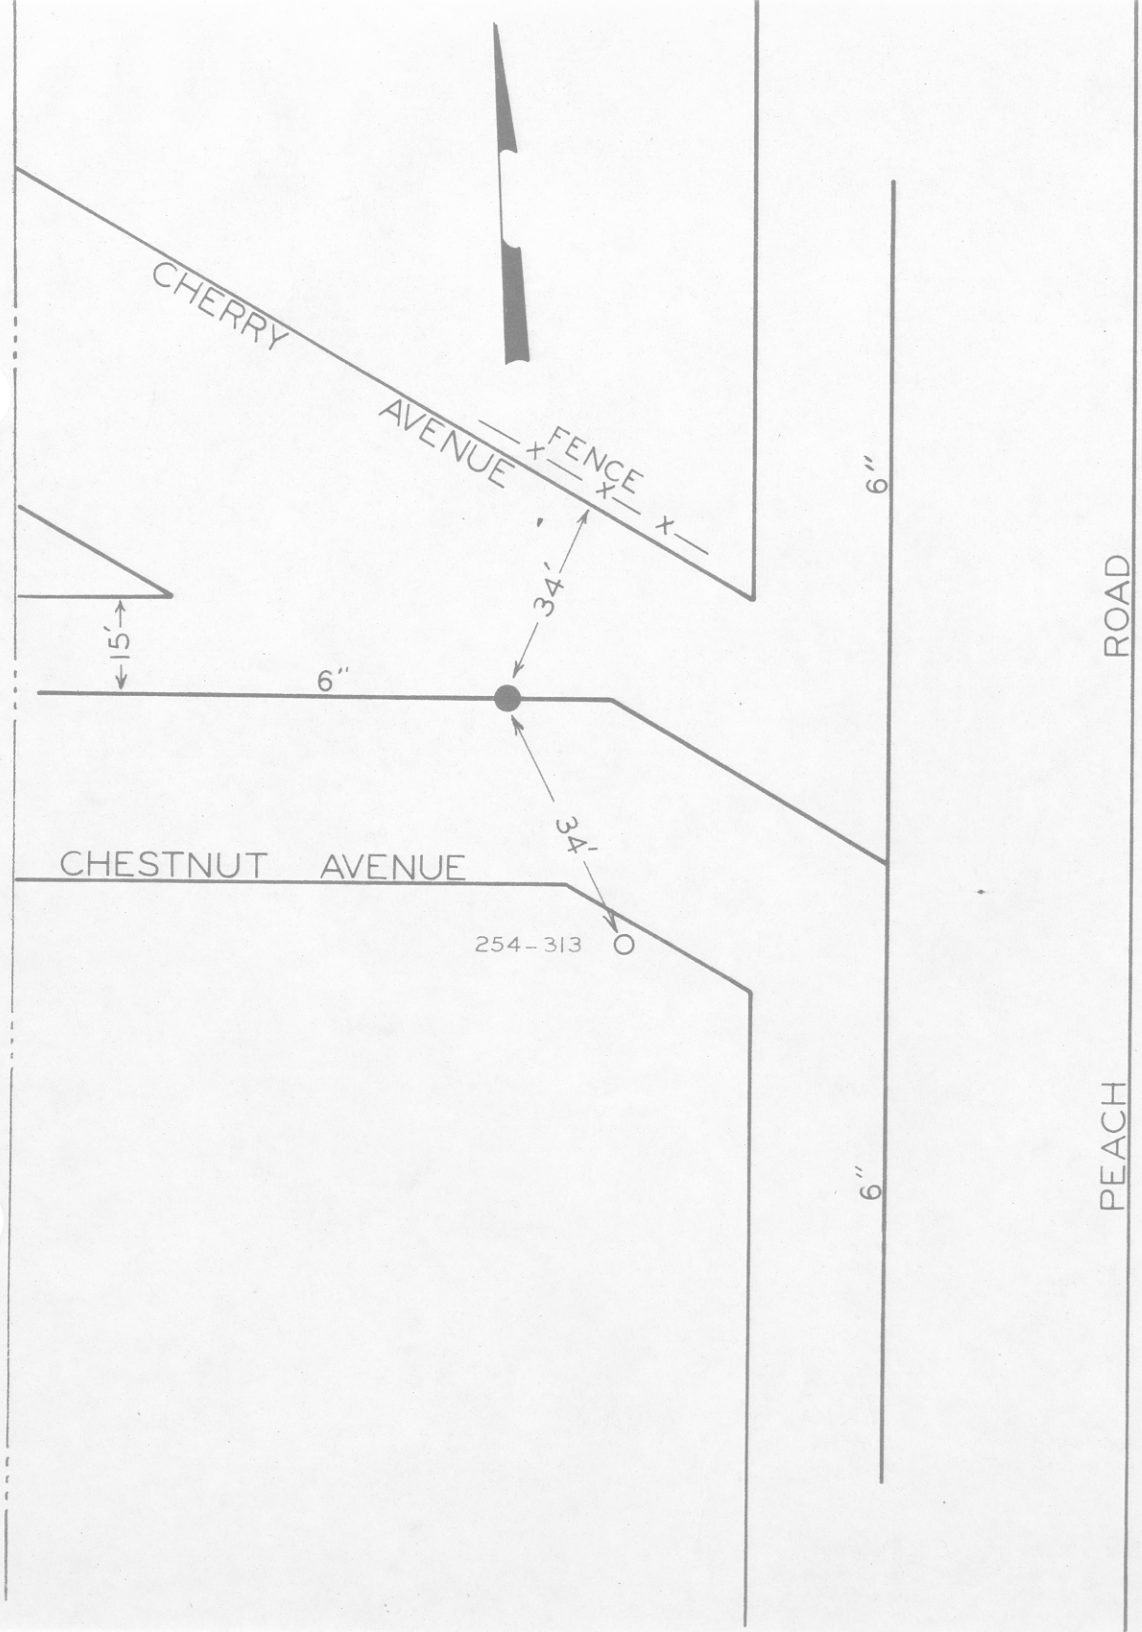

DATE	NO.	SIZE	MAKE	OPEN	TURNS
1-69	1	6"	MUELLER	R	

Gainsboro area

CITY OF ROANOKE — WATER DEPT.

VALVE DIAGRAM

CHERRY AVENUE, CHESTNUT AVENUE AND PEACH ROAD N.W.

SEC. MAP 202

DATE PAGE NO.