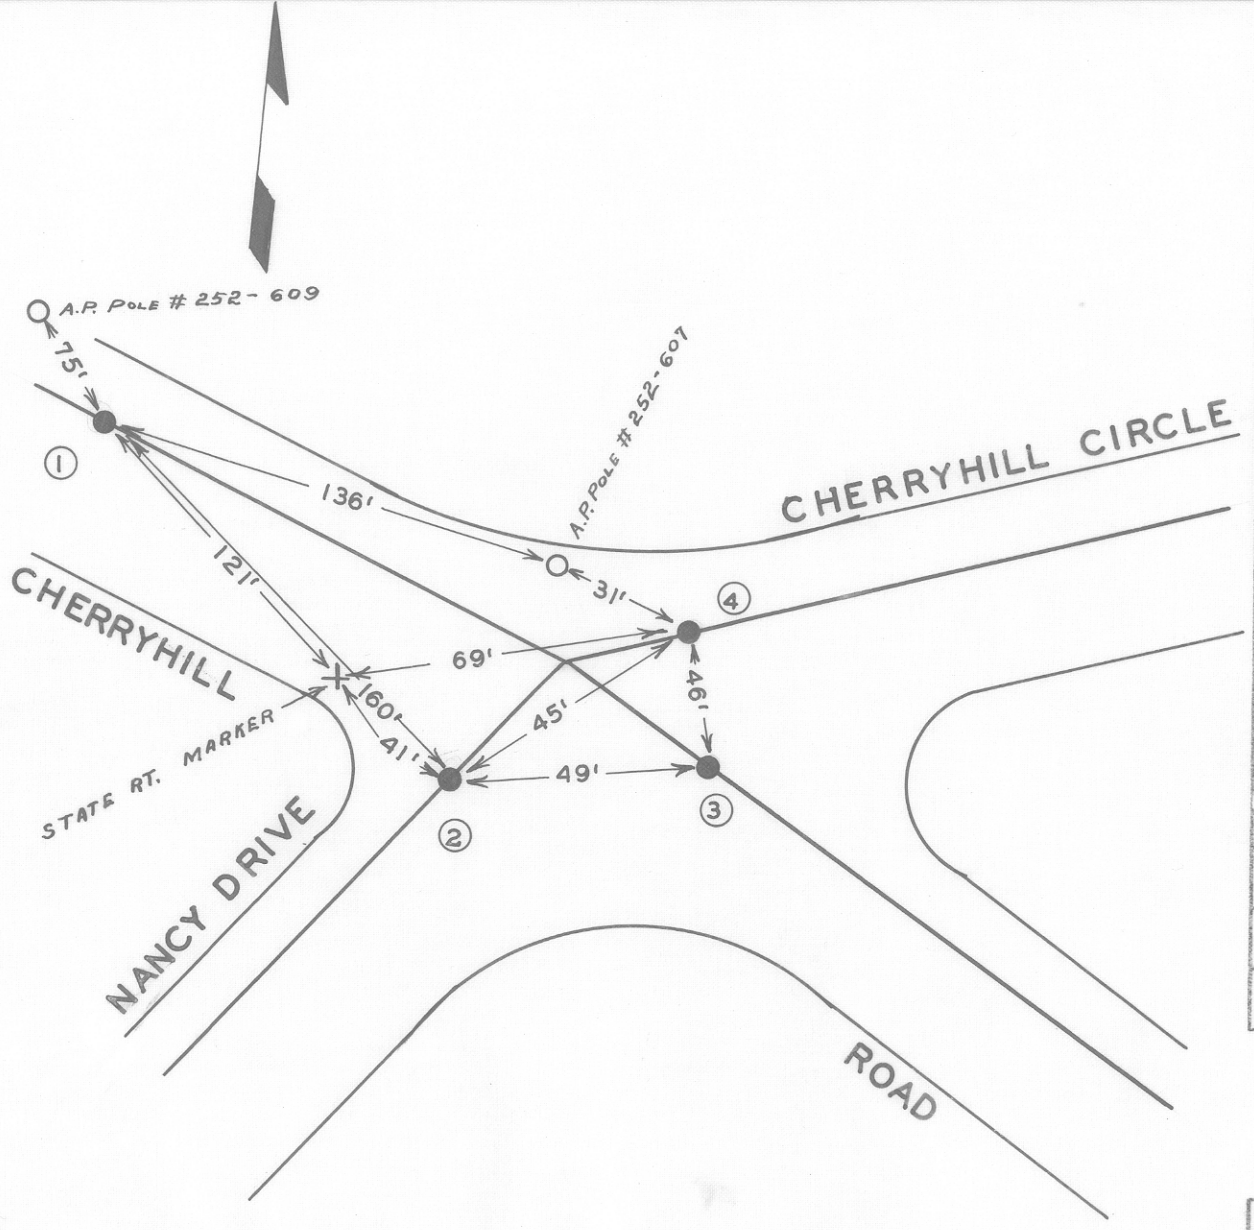

DATE	NO.	SIZE	MAKE	OPEN	TURNS
1959	1	6"	MUELLER	R	21
1960	2	6"	MUELLER	R	21
7-60	3	6"	MUELLER	R	21
8-62	4	6"	DARLING	R	21
	1	138'N	N.P.L.		
	2	0	W.P.L.		
	3	0	E.P.L.		
	4	0	N.P.L.		

CITY OF ROANOKE — WATER DEPT.

VALVE DIAGRAM

CHERRYHILL CIRCLE

CHERRYHILL ROAD &

NANCY DRIVE N.W.

SEC. MAP ~~29~~ 602 3

DATE PAGE NO.