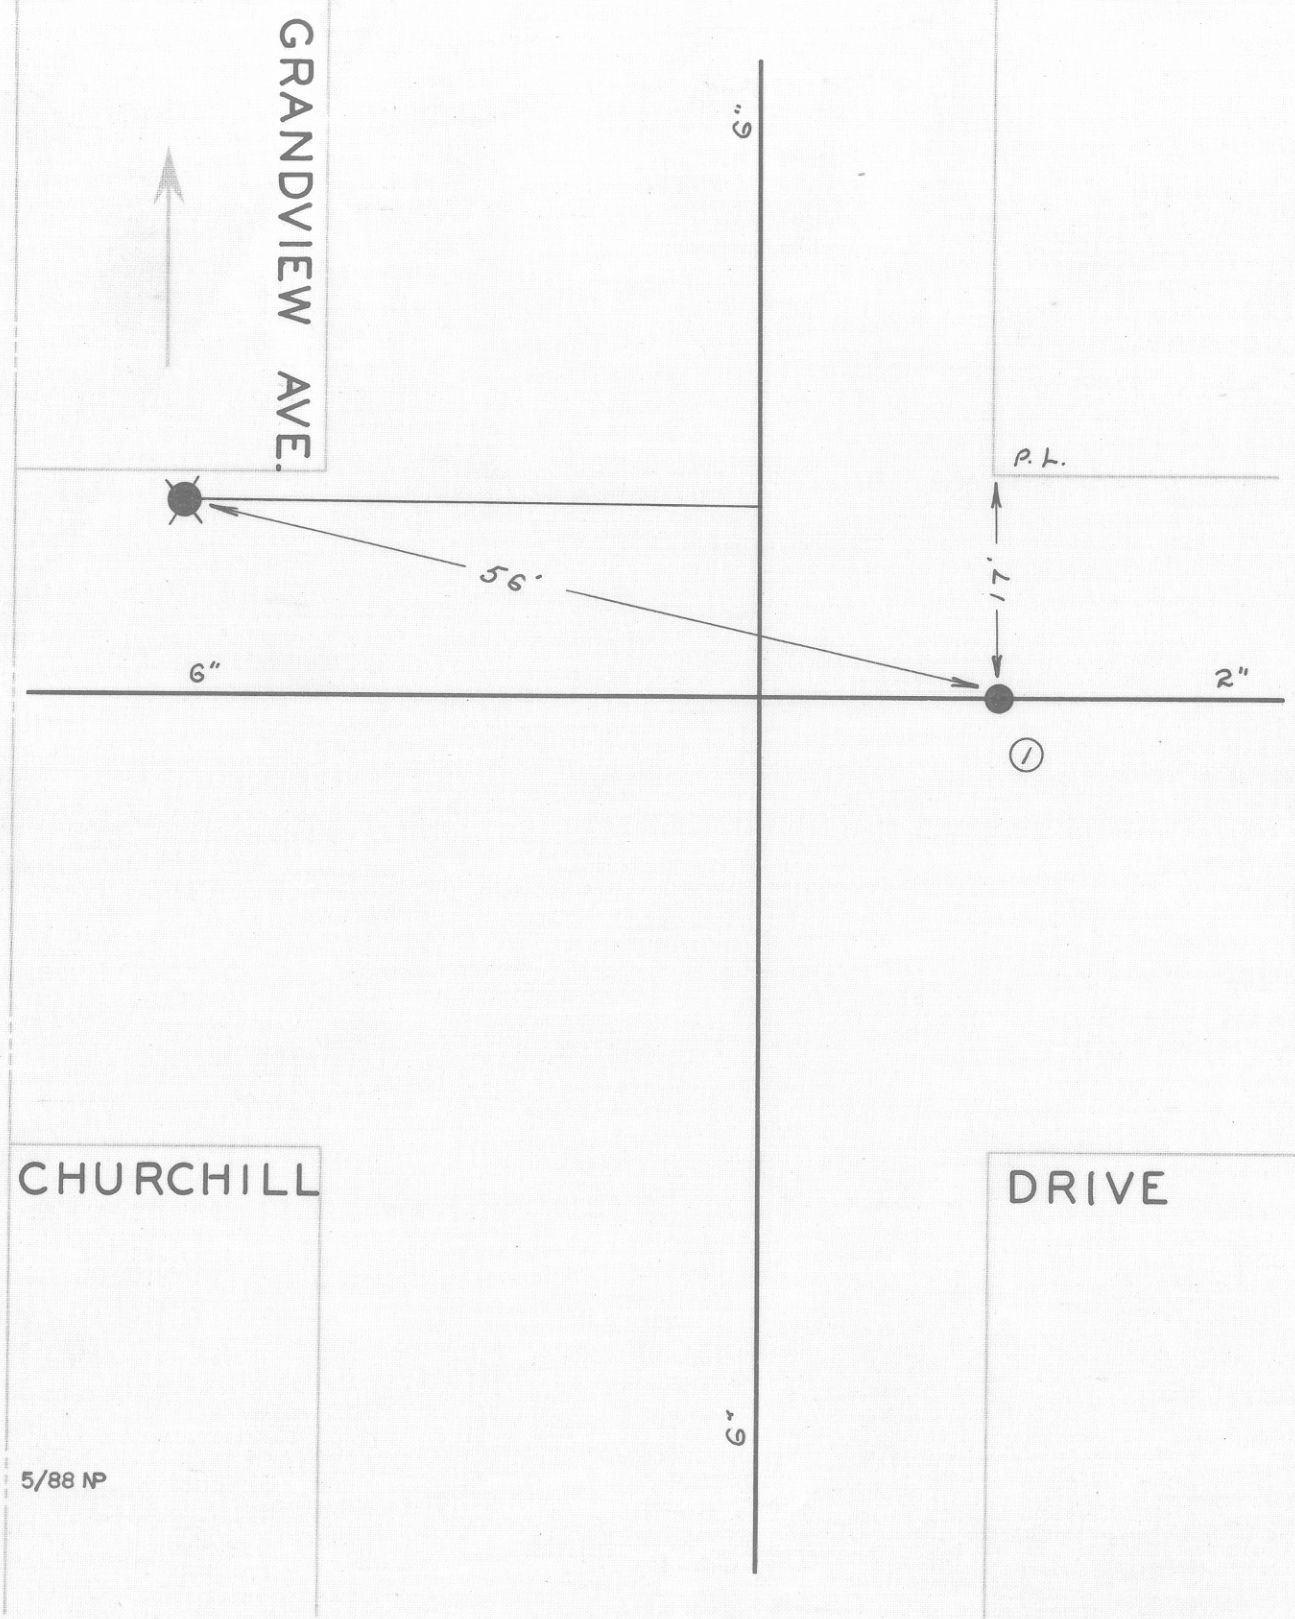

DATE	NO.	SIZE	MAKE	OPEN	TURNS
1955	1	2"			
	1	0	EPL		

CITY OF ROANOKE—WATER DEP'T

VALVE DIAGRAM

CHURCHILL DR.&

GRANDVIEW AVE. N. W.

SEC. MAP 227

DATE PAGE NO.