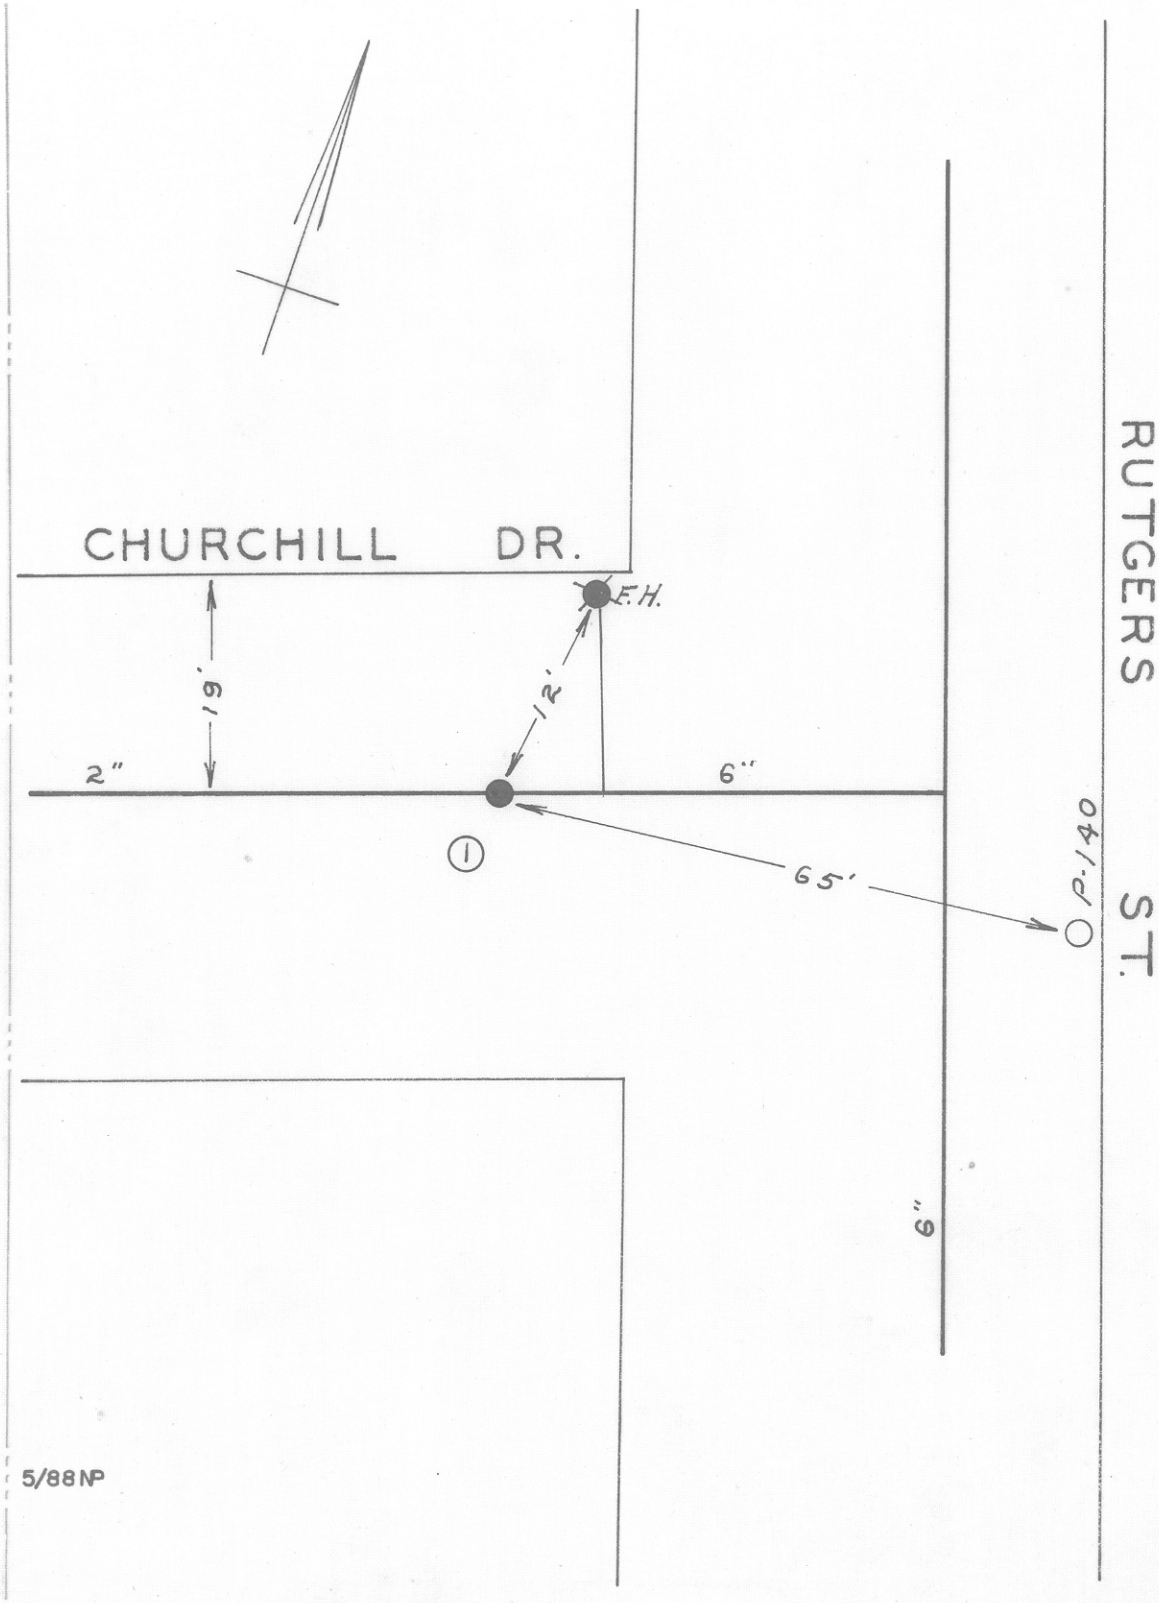

DATE	NO.	SIZE	MAKE	OPEN	TURNS
1953	1	2"	DARLING	R	7
	1	17'-W	WPL		

CITY OF ROANOKE—WATER DEPT.

VALVE DIAGRAM

CHURCHILL DR. & RUTGERS STREET N.W.

SEC. MAP 227

DATE PAGE NO.

"IMPERIAL" TRACING CLOTH K & E CO., N. Y.