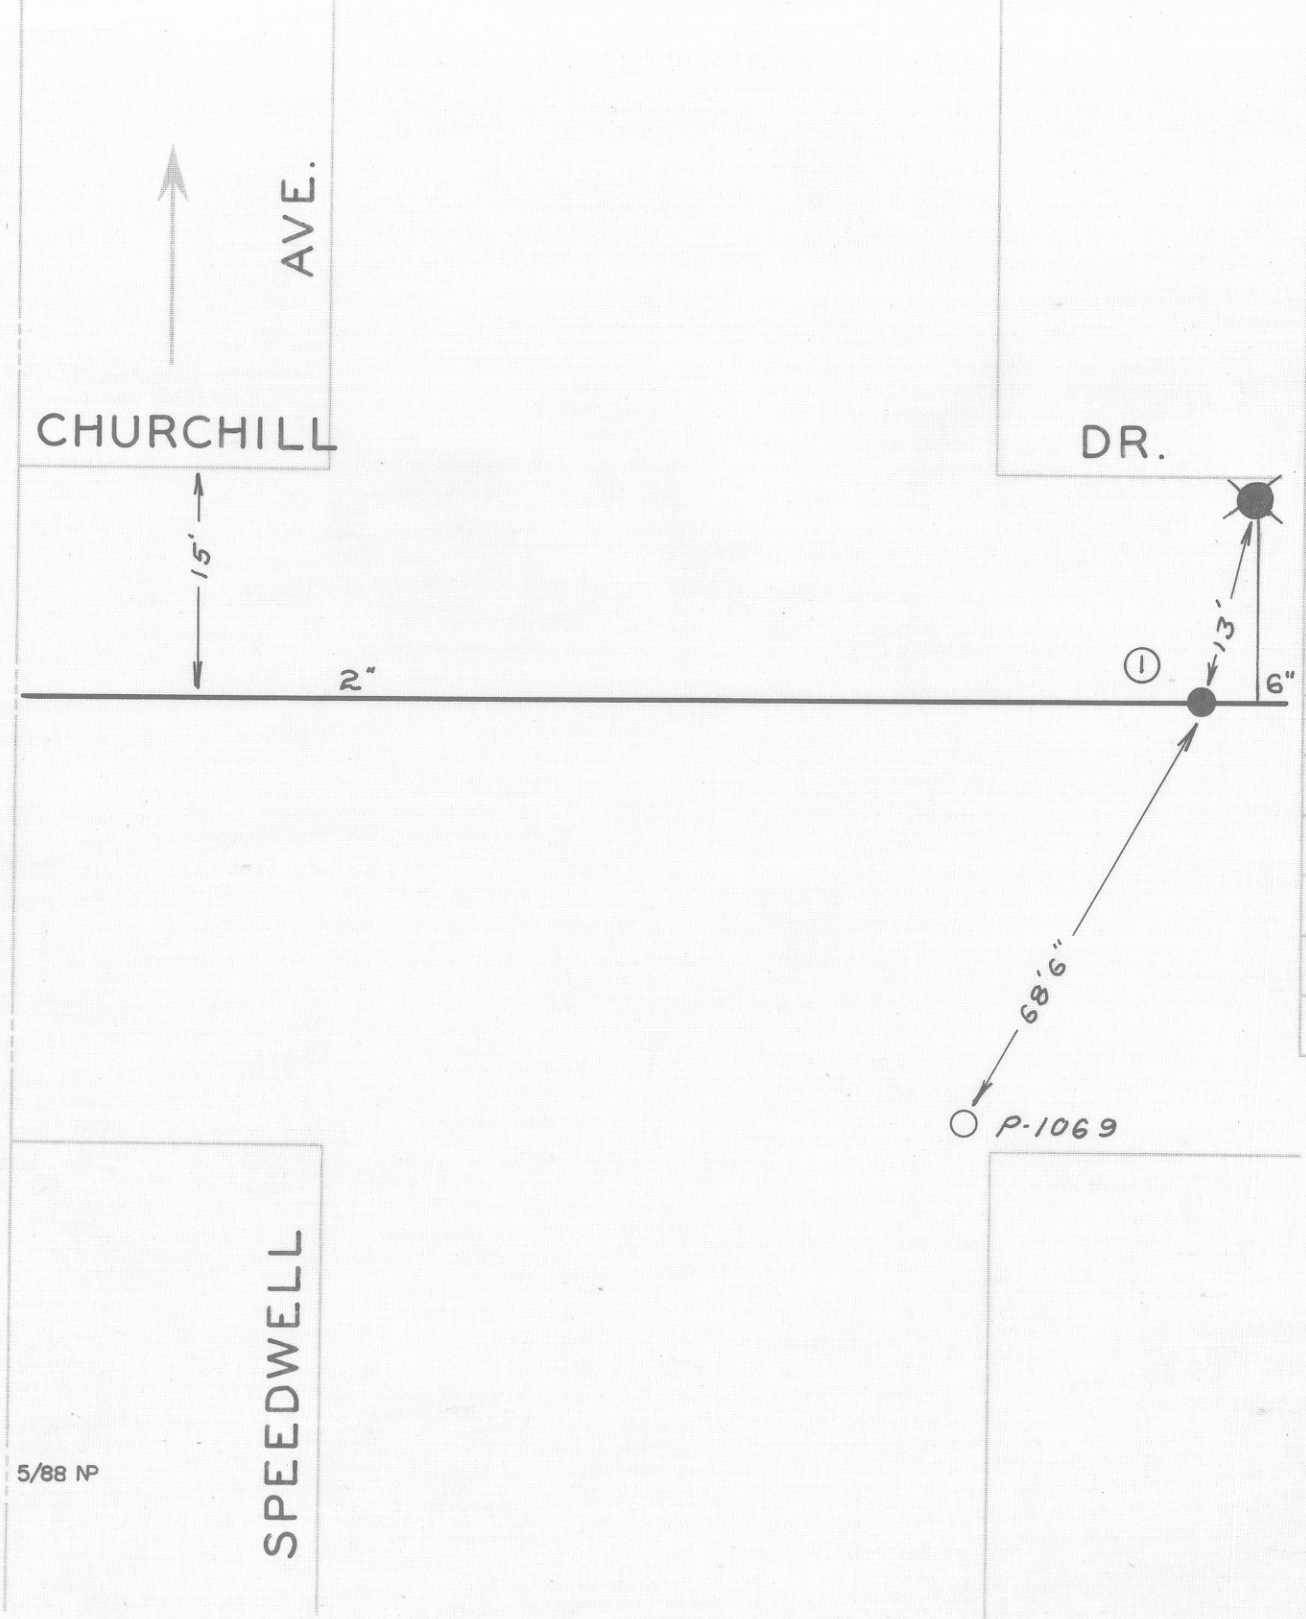

DATE	NO.	SIZE	MAKE	OPEN	TURNS
1951	1	2"			
	1	63'-E	EPL		

CITY OF ROANOKE—WATER DEP'T

VALVE DIAGRAM

CHURCHILL DR. & SPEEDWELL AVE. N. W.

SEC. MAP 227

DATE PAGE NO.

5/88 NP