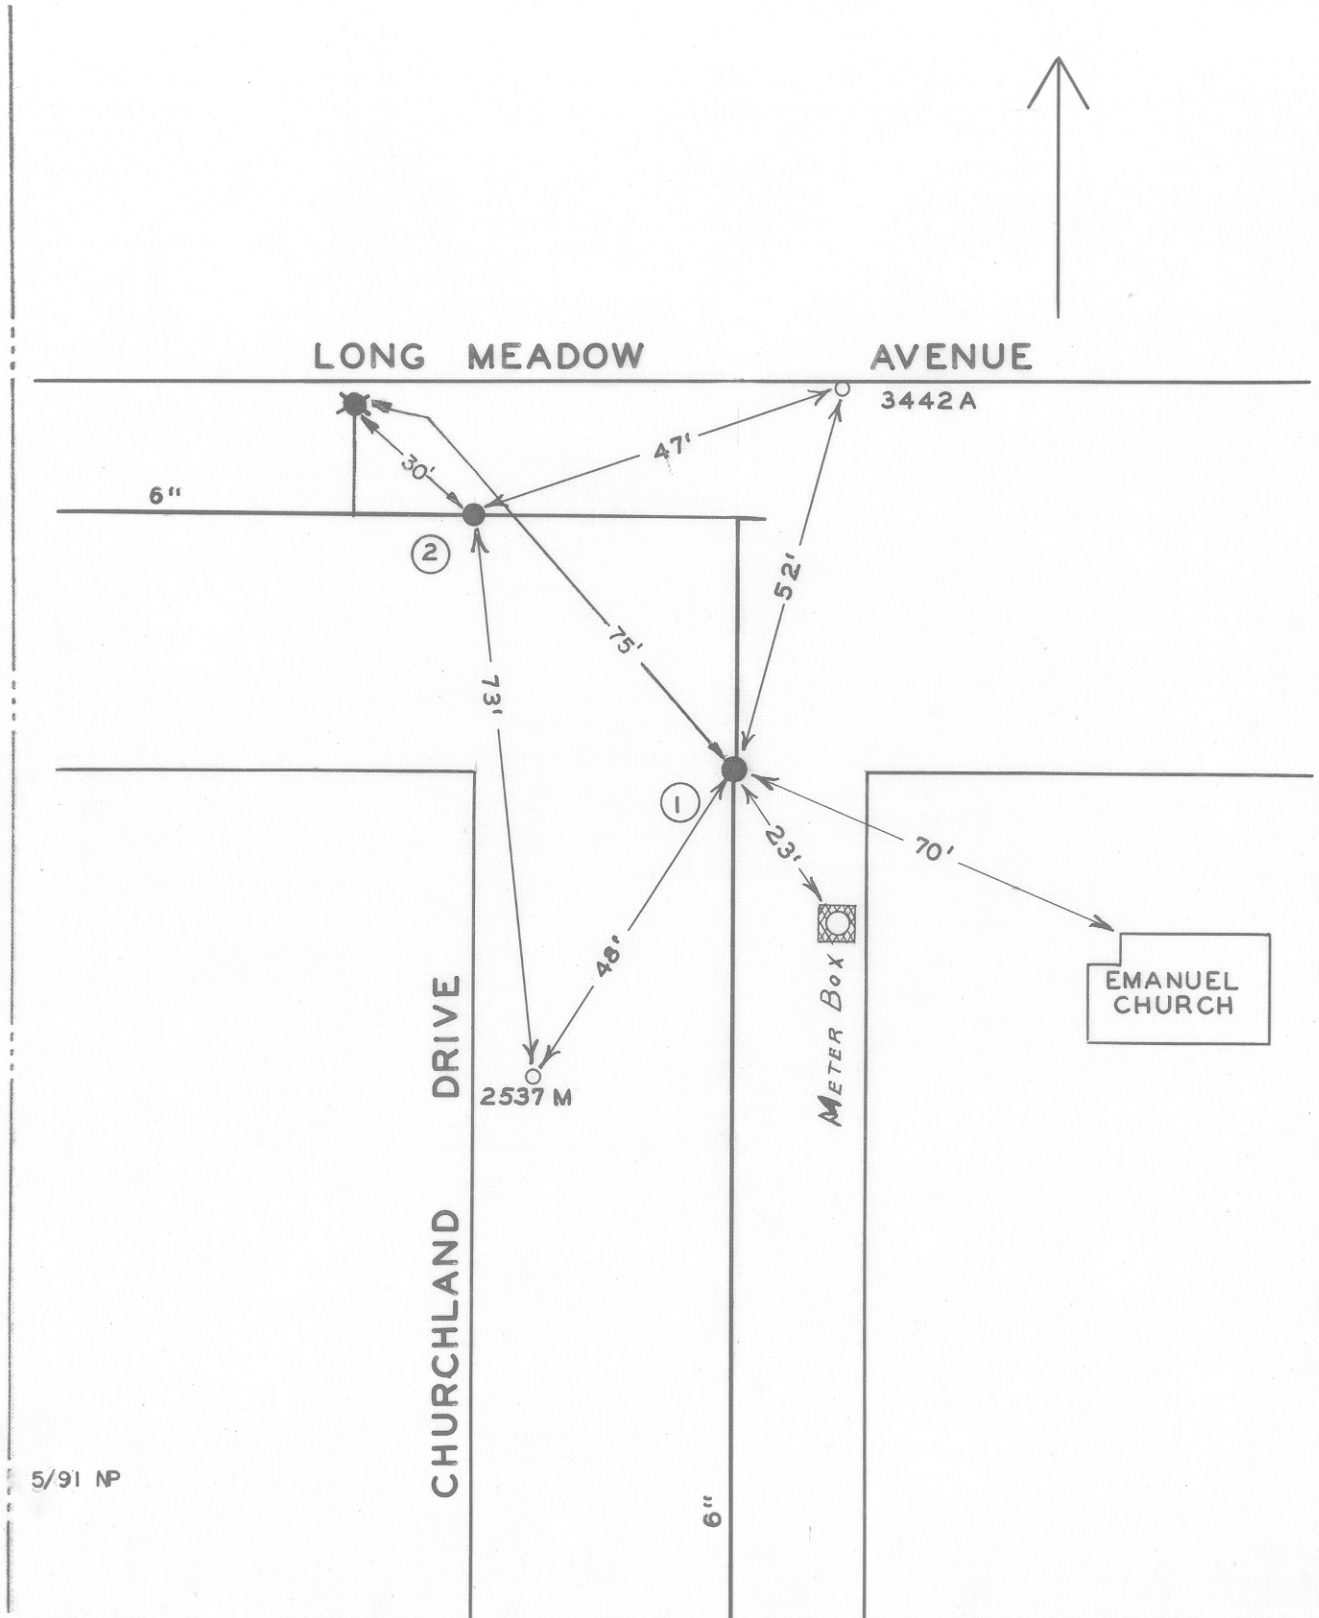

DATE	NO.	SIZE	MAKE	OPEN	TURNS
10-62	1	6"	MUELLER	R	21
1-63	2	6"	MUELLER	R	21
	1	0	S.P.L.		
	2	0	W.P.L.		

CITY OF ROANOKE — WATER DEPT.

VALVE DIAGRAM

CHURCHLAND DRIVE &

LONG MEADOW AVENUE N.W.

SEC. MAP 273

DATE PAGE NO.