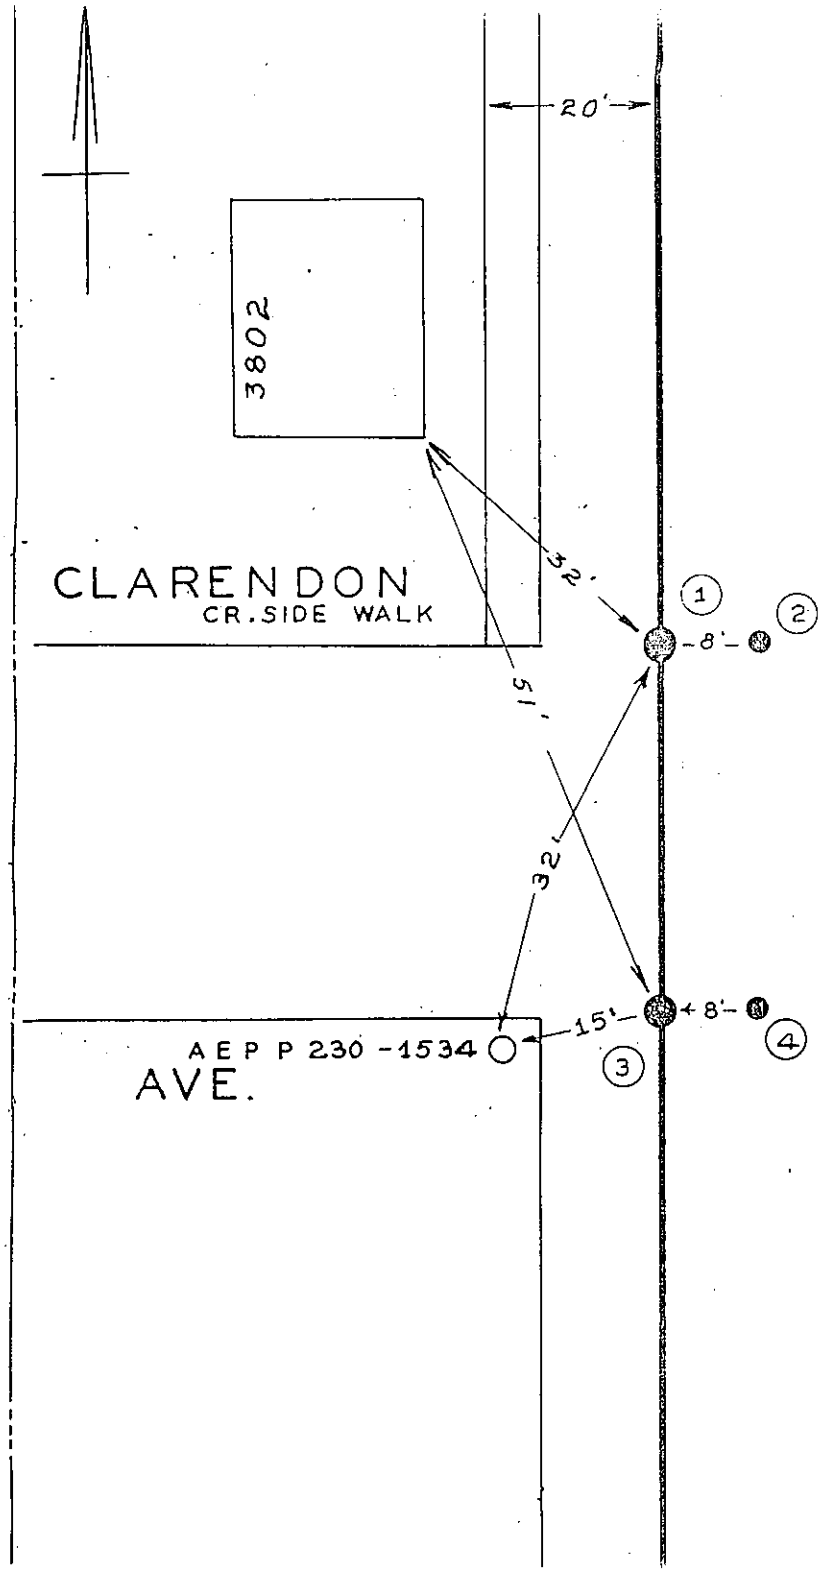

WILLIAMSON ROAD

DATE	NO.	SIZE	MAKE	OPEN	TURNS
1946	1	30"	M. & H.	L	125
1946	2	4"	BY PASS	L	9
1946	3	30"	M. & H.	L	125
1946	4	4"	BY PASS	L	9
	1	8'-S	NPL		
	2				
	3	4'-N	SPL		
	4				

CITY OF ROANOKE—WATER DEP'T

VALVE DIAGRAM

CLARENDON AVENUE &

WILLIAMSON ROAD

SEC. MAP

DATE

PAGE NO. NE118