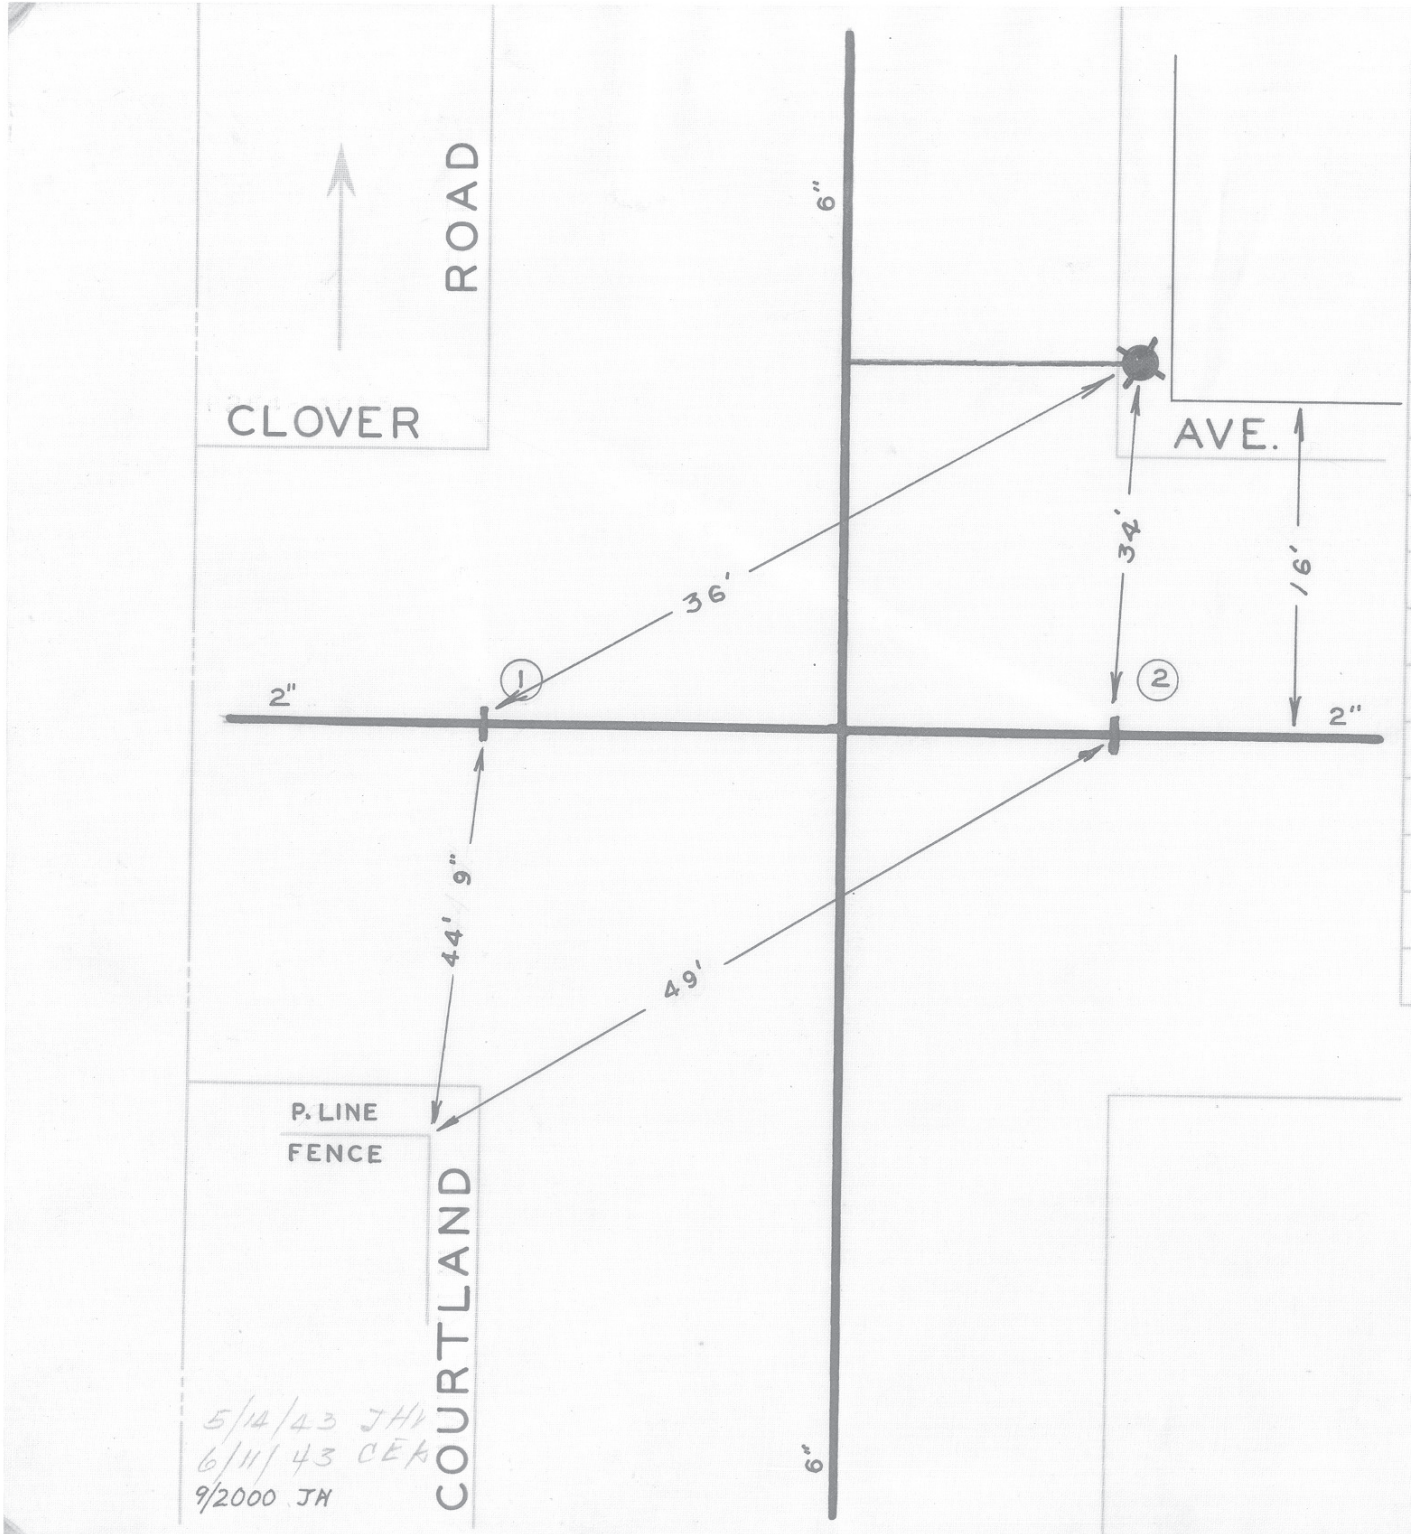

DATE	NO.	SIZE	MAKE	OPEN	TURNS
1924	1	2"		R	7
1926	2	2"		R	7
	1	19'-W	EPL		
	2	14'-W	EPL		

5/14/43 JH
6/11/43 CEK
9/2000 JH

CITY OF ROANOKE — WATER DEP'T
VALVE DIAGRAM
CLOVER AVE. & COURTLAND
COURTLAND ROAD
SEC. MAP 308 N.W.
DATE PAGE NO. 1 E. 82