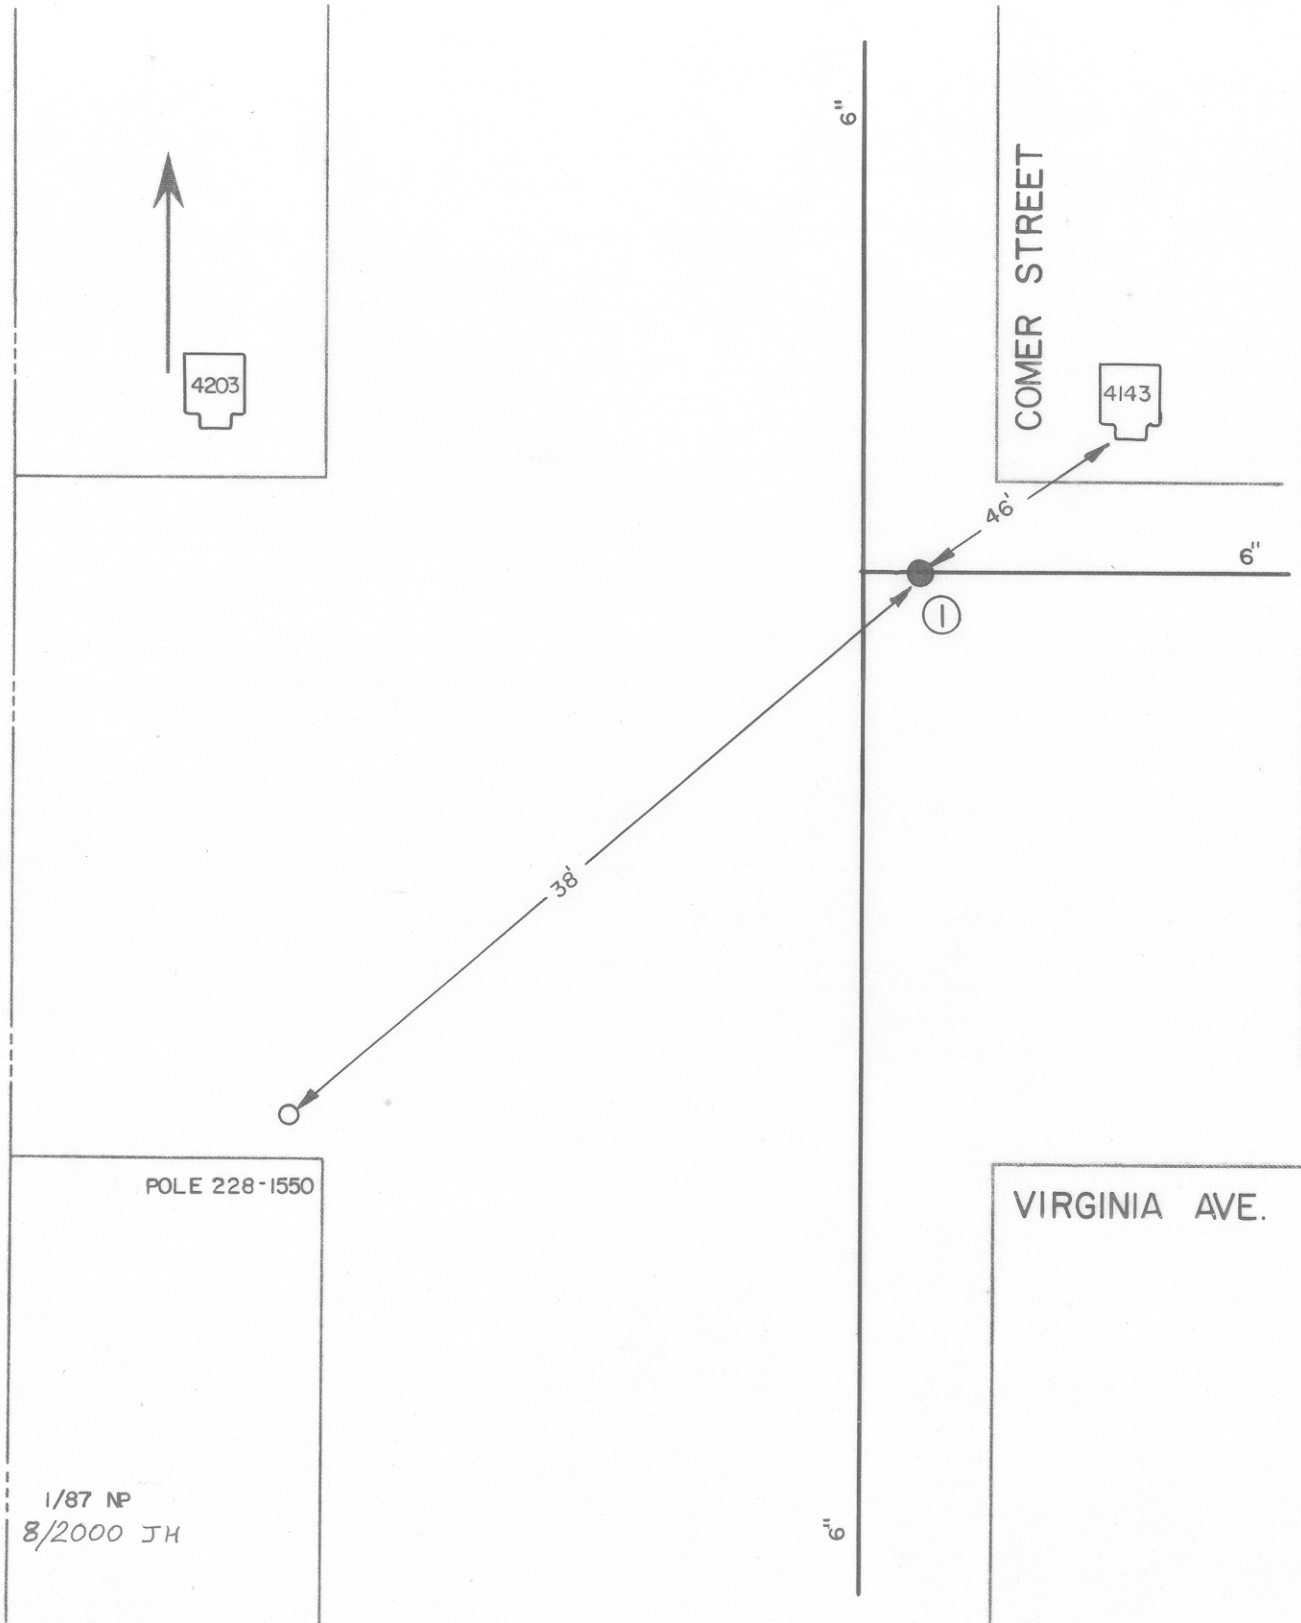

DATE	NO.	SIZE	MAKE	OPEN	TURNS
11-74	1	6"	MUELLER	R	

CITY OF ROANOKE—WATER DEP'T

VALVE DIAGRAM

COMER STREET &

VIRGINIA AVENUE

NW

SEC. MAP 276

DATE PAGE NO.

1/87 NP

8/2000 JH