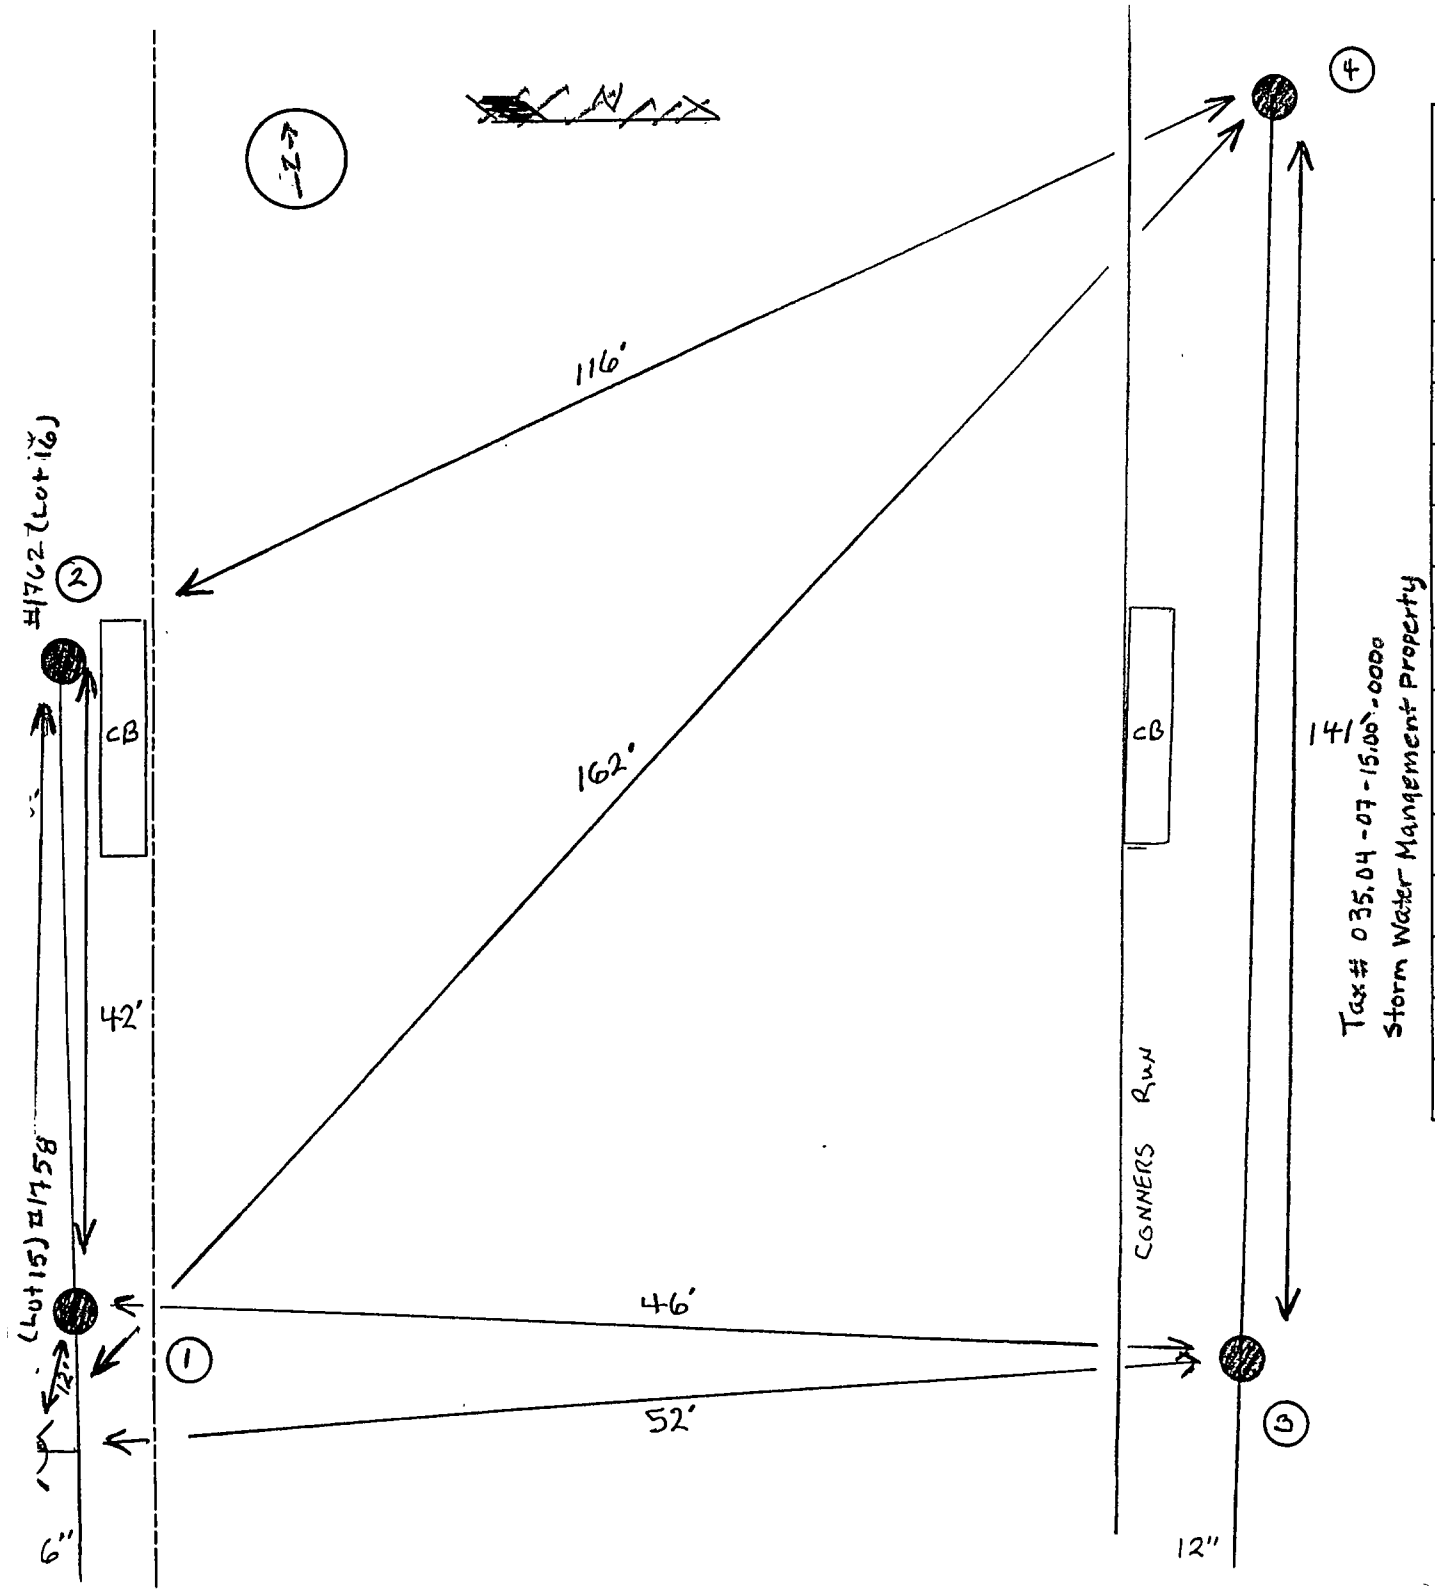

DATE	NO.	SIZE	MAKE	OPEN	TURNS
12/04	1	16"	MUELLER	L	105
12/04	2	2"	BLOWOFF		
12/04	3	12"	MUELLER	L	39
12/04	4	2"	BLOWOFF		

WESTERN VIRGINIA WATER AUTHORITY

VALVE DIAGRAM

CONNERS RUN LOT 16

HANGING ROCK TERRACE

SECT. MAP NW COUNTY

DATE 12-23-04