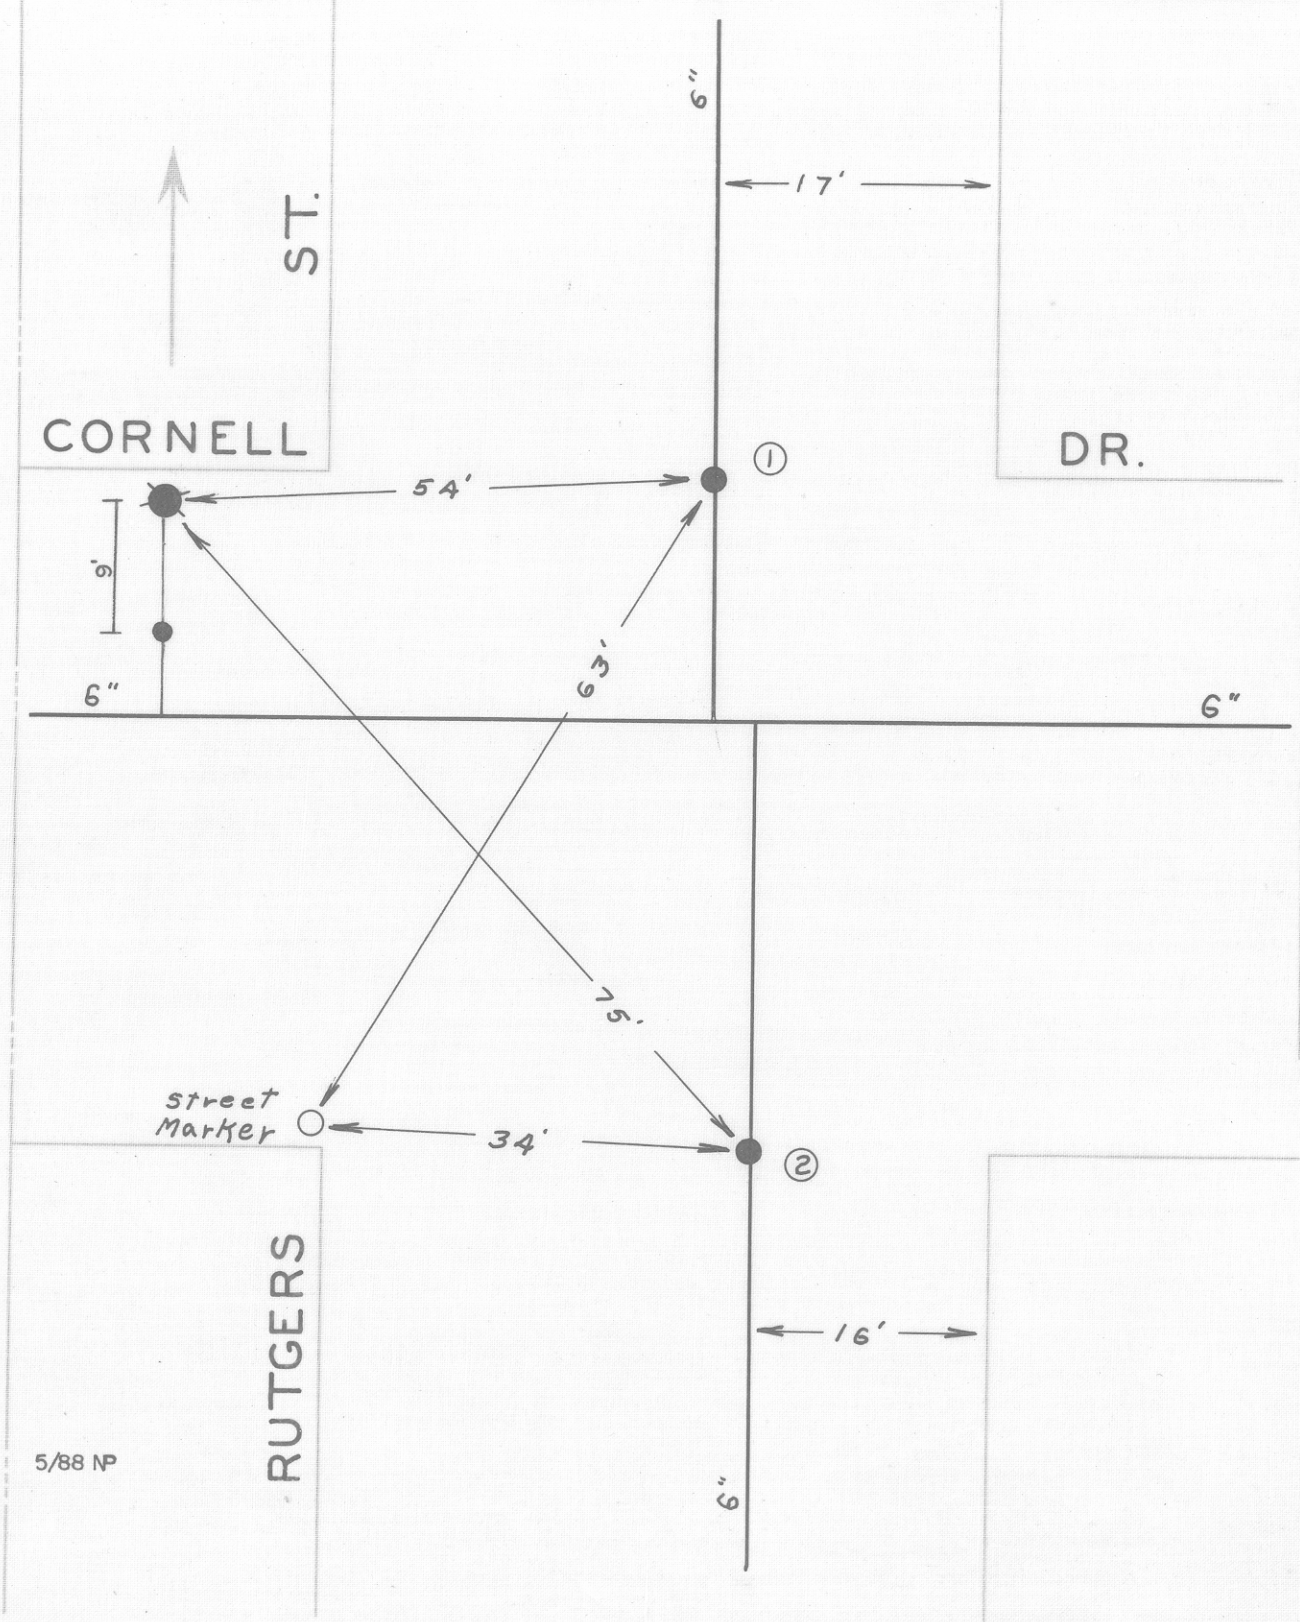

DATE	NO.	SIZE	MAKE	OPEN	TURNS
1953	1	6"			
1951	2	6"			
	1	0	NPL		
	2	0	SPL		

CITY OF ROANOKE—WATER DEP'T

VALVE DIAGRAM

CORNELL DR.& RUTGERS ST. N.W.

SEC. MAP 226,228

DATE W.R. PAGE NO.

5/88 NP