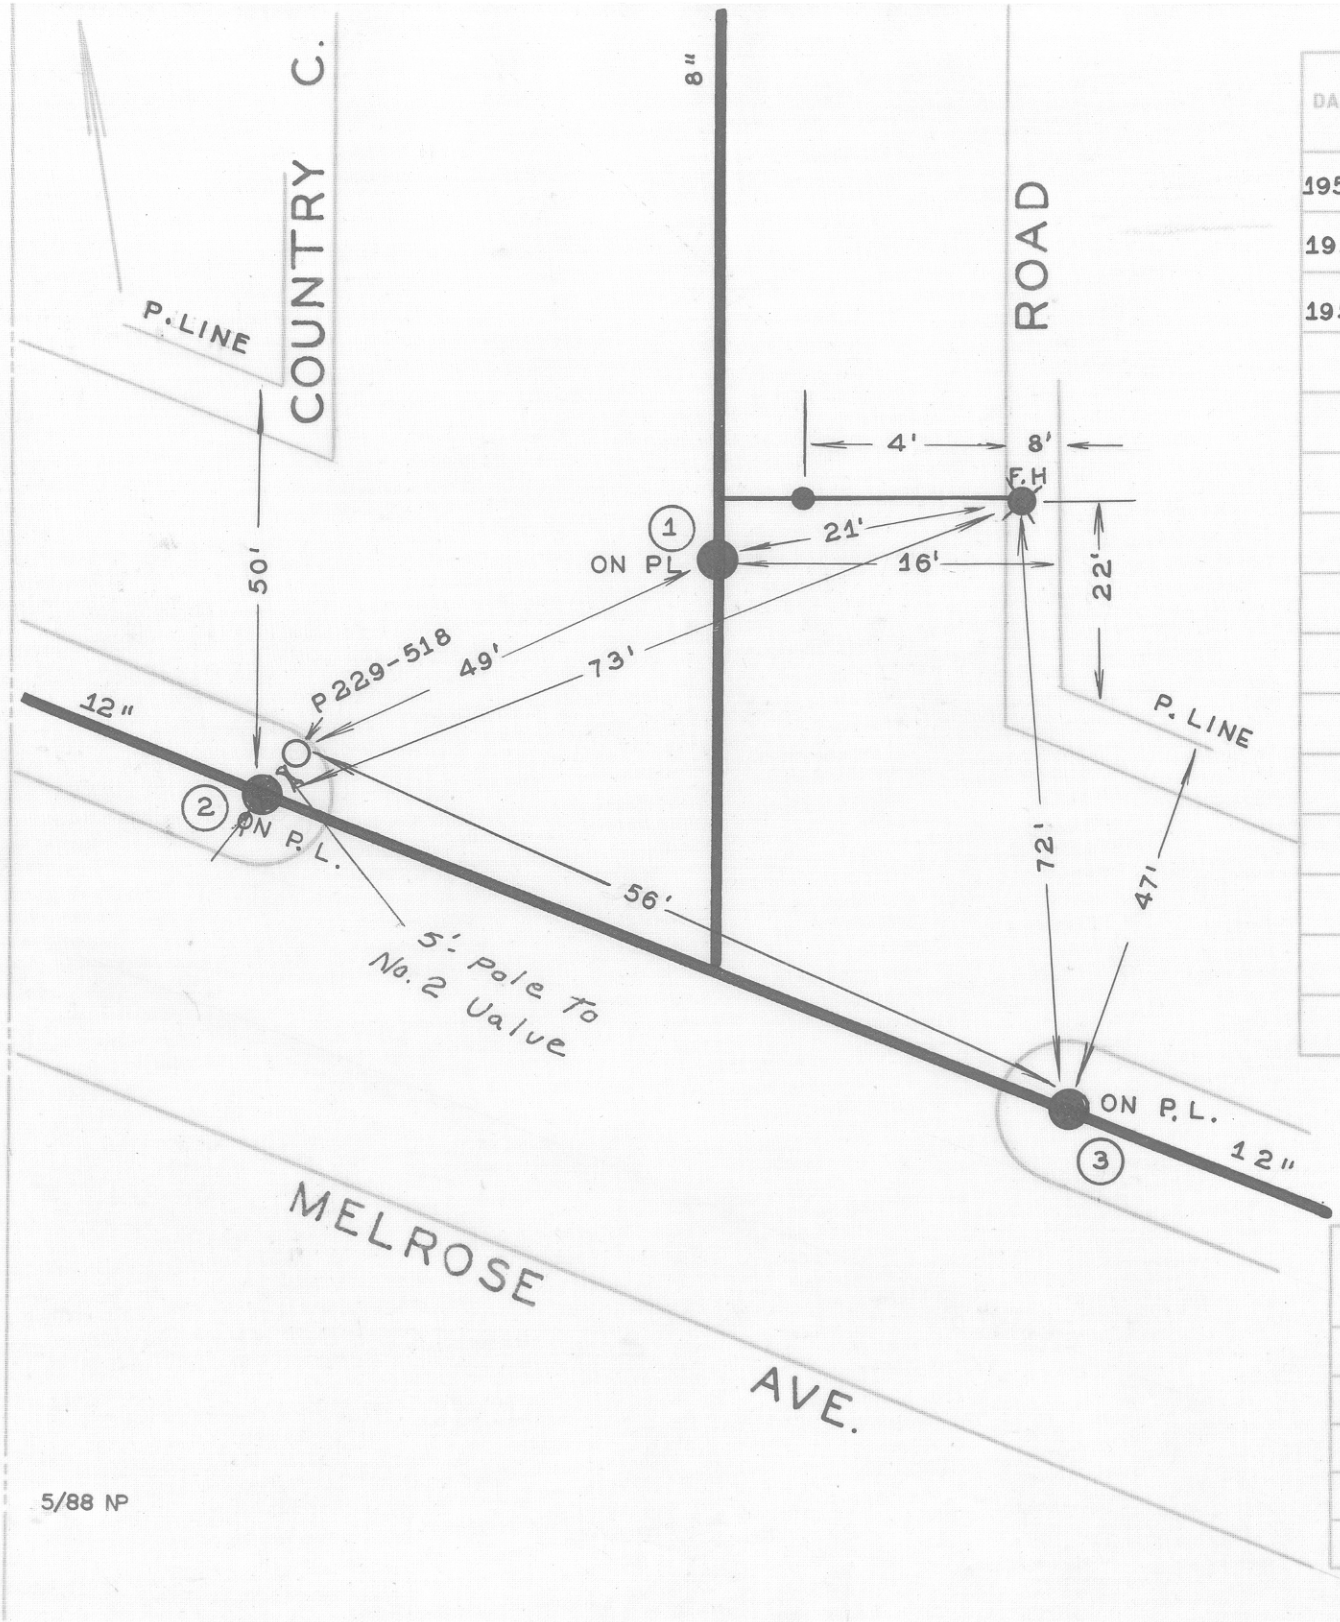

DATE	NO.	SIZE	MAKE	OPEN	TURNS
1950	1	8"	DARLING	R	27
1950	2	12"	DARLING	R	40
1950	3	12"	DARLING	R	39
	1	0	NPL		
	2	21'-W	WPL		
	3	0	EPL		

CITY OF ROANOKE—WATER DEP'T

VALVE DIAGRAM

COUNTRY CLUB DRIVE &

MELROSE AVENUE N.W.

SEC. MAP 266

DATE

PAGE NO. N.W.359

5/88 NP