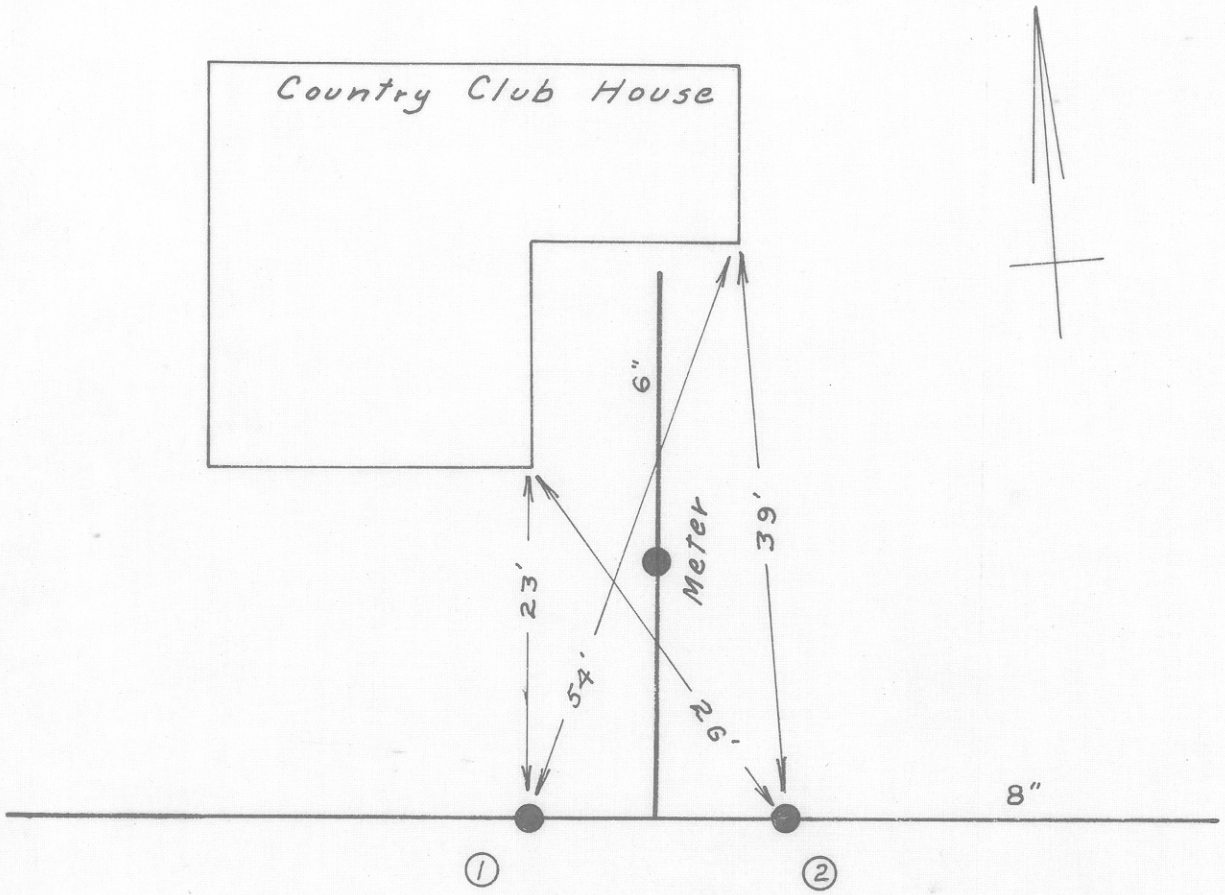

DATE	NO.	SIZE	MAKE	OPEN	TURNS
1952	1	8"	MUELLER	R	27
1952	2	8"	MUELLER	R	27

CITY OF ROANOKE—WATER DEPT.

VALVE DIAGRAM

COUNTRY CLUB HOUSE

OFF COUNTRY CLUB DRIVE

SEC. MAP 266 N.W.

DATE PAGE NO.

5/88 NP

"IMPERIAL" TRACING CLOTH. K & E CO., N. Y.