DATE	NO.	SIZE	MAKE	OPEN	TURNS
69	1	12"	MUELLER	R	39
69	2	6"	MUELLER	R	21

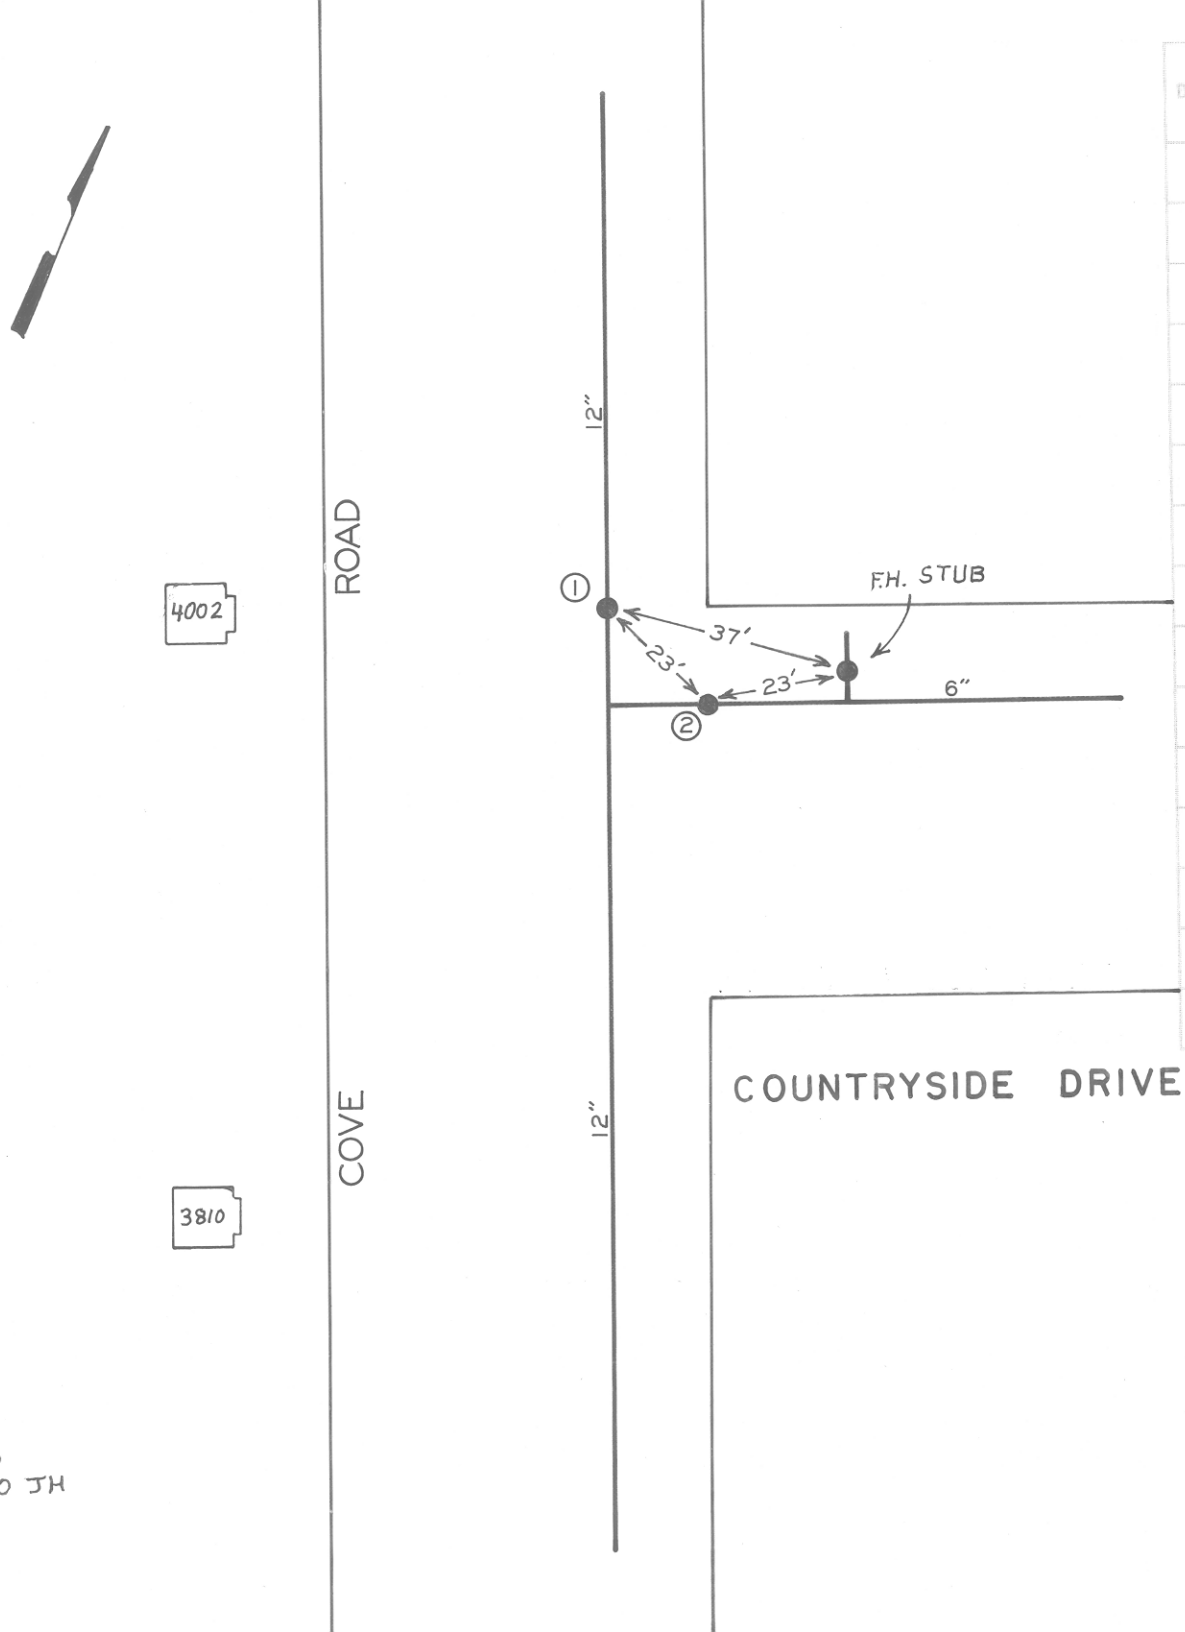

CITY OF ROANOKE—WATER DEP'T
VALVE DIAGRAM

COUNTRYSIDE DR.

COVE ROAD N.W.

SEC. MAP 643, 640

DATE PAGE NO.

3/91 NP
8/2000 JH