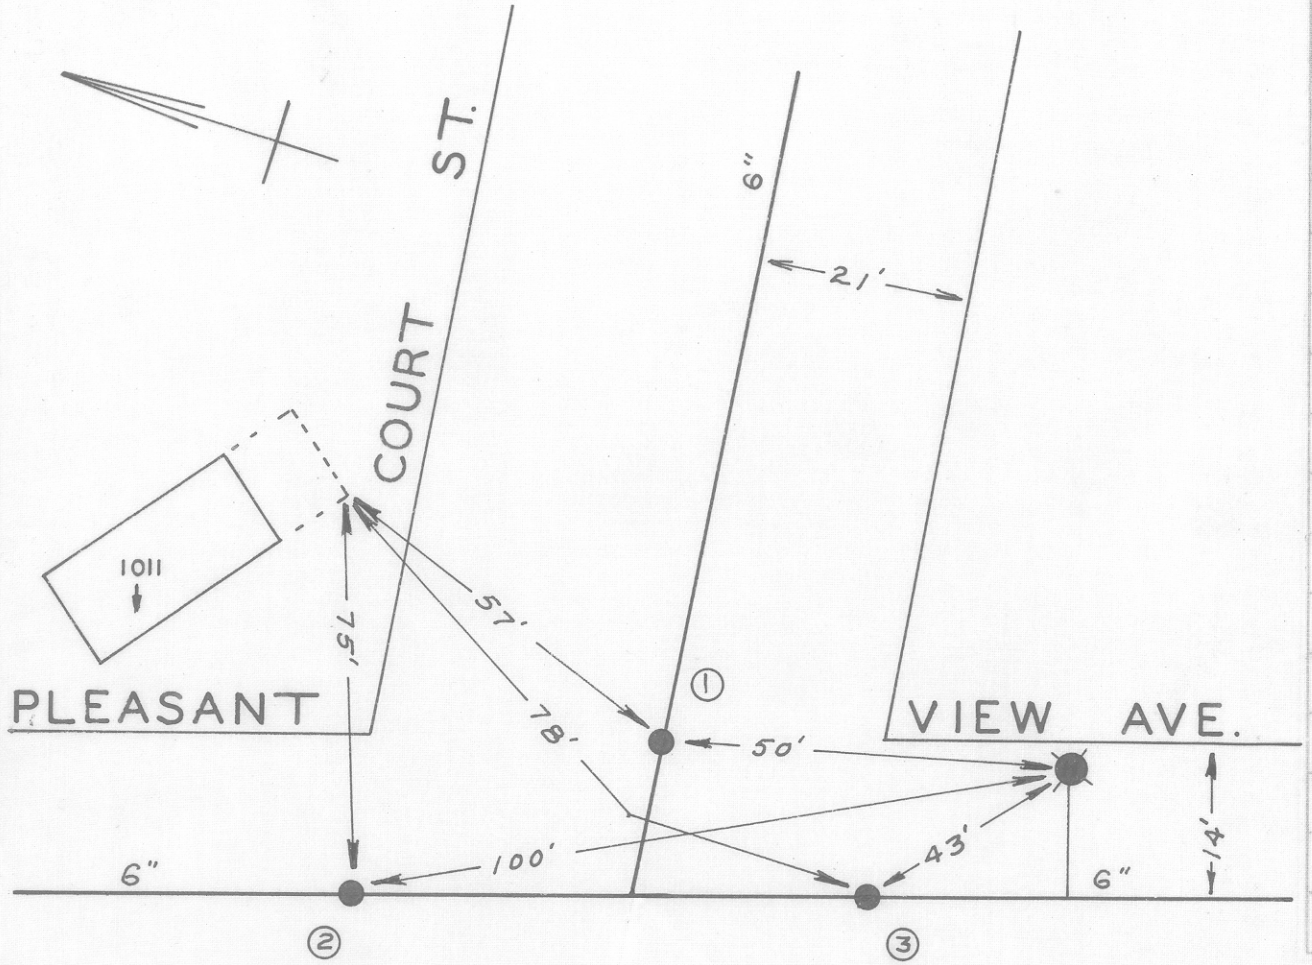

DATE	NO.	SIZE	MAKE	OPEN	TURNS
1954	1	6"	MUELLER	R	20
1954	2	6"	MUELLER	R	20
1954	3	6"	MUELLER	R	20
	1	0	EPL		
	2	0	NPL		
	3	0	SPL		

5/88 NP

Catch Basin

CITY OF ROANOKE—WATER DEPT.

VALVE DIAGRAM

COURT ST. & PLEASANT

VIEW AVE. N.W.

SEC. MAP 214

DATE PAGE NO.

"IMPERIAL" TRACING CLOTH
K & E CO., N. Y.